DIRECTION	MILEPOINT	LOCATION CODE (SHEET 2)	SIGN CODE	WIDTH (IN)	HEIGHT (IN)	SHEETING REMARKS	SIGN LEGEND	NEW SIGNS		EXISTING SIGNS				EXIST POST		NUMBER OF NEW POSTS	SQUARE STEEL (IN)			TUBULAR STEEL Ø (IN)					SIGN FRAME REQUIRED	REMARKS	SIGN DETAIL LOCATION		
								"A"	"B"	RETAIN	SALVAGE FROM	SALVAGE TO	REMOVE	RETAIN	REMOVE		1.75 (LB / FT) 1.88	2.00 (LB / FT) 2.42	2.50 (LB / FT) 3.35	FOUNDATION	3.00 (LB / FT) 7.60	3.50 (LB / FT) 9.00	4.00 (LB / FT) 10.80	5.00 (LB / FT) 14.60			SHSM	PROJECT SHEET #	STANDARD SHEET #
ENOSBURG VT105 EB							FY-FLUORESCENT YELLOW FYG-FLUORESCENT YELLOW GREEN																		"SHSM"-STANDARD HIGHWAY SIGNS AND MARKINGS			
		A	M1-5	30	24								1															
		A	M6-2R	21	15								1															
		A	VD1-1A	72	12			6.00												2	235.6						4	
		A	VD1-1A	72	12			6.00																			4	
		A	M3-1	24	12			2.00																	#2B	GREEN ON WHITE	X	6	
		A	M1-5	30	24		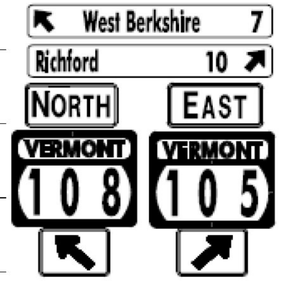	5.00																			E-136B
		A	M6-2L	21	15			2.19																		GREEN ON WHITE	X		
		A	M3-2	24	12			2.00																		GREEN ON WHITE	X		
		A	M1-5	30	24			5.00																				E-136B
		A	M6-2R	21	15			2.19																		GREEN ON WHITE	X		
EB	1.200	A	M3-1	24	12			2.00								1		X								INSTALL DIRECTLY ACROSS FROM INTERSECTION WITH ROUTE 108. GREEN ON WHITE	X		
		A	M1-5	30	24			5.00																				E-136B
		A	M6-1L	21	15			2.19																		GREEN ON WHITE	X		
EB	1.220	A	M3-2	24	12			2.00								1		X								INSTALL 105' +/- EAST OF INTERSECTION OF VT 108. GREEN ON WHITE	X		
		A	M1-5	30	24			5.00																				E-136B
SIGN SUMMARY SHEET							SHEET TOTALS	46.57	0.00	0	0	0	2	0	0	2		30.0		2	235.6	0.0	0.0	0.0				
								SF	SF	EA	EA	EA	EA	EA	EA	EA		FT		EA	LB	LB	LB	LB				
VERMONT AGENCY OF TRANSPORTATION							TOWN DIRECTIONAL TOTALS	393.9	0.0	25	4	4	94	0	0	58		870.0		2	235.6							

PROJECT NAME: **St Albans - Berkshire**
PROJECT NUMBER: **STPG SIGN(36)**

FILE NAME: **EnosburgEB.xls** PLOT DATE: **5/17/2011**
PROJECT MANAGER: **A. Gamble** DRAWN BY: **T. Guazzoni**
DESIGNED BY: **T. Guazzoni** CHECKED **A. Gamble**
ENOSBURG EB SHEET 10 SHEET **75** OF **109**