DIRECTION	MILEPOINT	LOCATION CODE (SHEET 2)	SIGN CODE	WIDTH (IN)	HEIGHT (IN)	SHEETING REMARKS	SIGN LEGEND	NEW SIGNS		EXISTING SIGNS				EXIST POST		NUMBER OF NEW POSTS	SQUARE STEEL (IN)			TUBULAR STEEL Ø (IN)				SIGN FRAME REQUIRED	REMARKS	SIGN DETAIL LOCATION		
								"A"	"B"	RETAIN	SALVAGE FROM	SALVAGE TO	REMOVE	RETAIN	REMOVE		1.75 (LB / FT) 1.88	2.00 (LB / FT) 2.42	2.50 (LB / FT) 3.35	FOUNDATION	3.00 (LB / FT) 7.60	3.50 (LB / FT) 9.00	4.00 (LB / FT) 10.80	5.00 (LB / FT) 14.60			SHSM	PROJECT SHEET #	STANDARD SHEET #
ENOSBURG VT105 WB							FY-FLUORESCENT YELLOW FYG-FLUORESCENT YELLOW GREEN																		"SHSM"-STANDARD HIGHWAY SIGNS AND MARKINGS			
WB	0.880	F	VR-004A	24	30		YIELD TO PEDESTRIAN IN CROSSWALK						1		X													
WB	0.860	F	W11-2	30	30		PEDESTRIAN			1				X														
		F	W16-7pL	24	12		LEFT DIAGONAL ARROW			1																		
		E	W11-2	30	30	**FYG**		6.25																	INSTALL SIGNS BACK TO BACK TO EXISTING	X		
		E	W16-7pR	24	12	**FYG**		2.00																	NOTE THAT ARROW POINTS RIGHT	X		
WB	0.764	F	W11-2	30	30		PEDESTRIAN			1				X														
		F	W16-7pL	24	12		LEFT DIAGONAL ARROW			1																		
WB	0.755	F	M3-4	24	12		WEST						1		X													
		F	M1-5	30	24		VERMONT 105						1															
		F	M6-1R	21	15		RIGHT ARROW						~~1~~ 2															
WB	0.735	F	M3-3	24	12		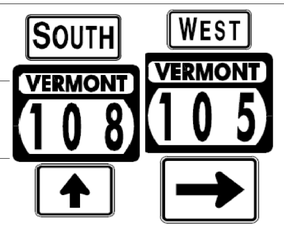	2.00								~~1~~ 2		X							#2B	GREEN ON WHITE. INSTALL 105' +/- WEST OF EXISTING LOCATION	X		
		F	M1-5	30	24			5.00																				E-136B
		F	M6-3	21	15			2.19																	GREEN ON WHITE	X		
		F	M3-4	24	12			2.00																	GREEN ON WHITE	X		
		F	M1-5	30	24			5.00																				E-136B
							SHEET TOTALS	24.44	0.00	4	0	0	~~4~~ 5	0	0	1		15.0		0	0.0	0.0	0.0	0.0				
								SF	SF	EA	EA	EA	EA	EA	EA	EA		FT		EA	LB	LB	LB	LB				
							TOWN DIRECTIONAL TOTALS	359.7	0.0	23	0	0	89	0	0	51		765.0		2		171.0						

SIGN SUMMARY SHEET

VERMONT AGENCY OF TRANSPORTATION

PROJECT NAME: **St Albans - Berkshire**
PROJECT NUMBER: **STPG SIGN(36)**

FILE NAME: **EnosburgWB.xls** PLOT DATE: **5/17/2011**
PROJECT MANAGER: **A. Gamble** DRAWN BY: **T. Guazzoni**
DESIGNED BY: **T. Guazzoni** CHECKED **A. Gamble**
ENOSBURG WB SHEET 10 SHEET **90** OF **109**