DIRECTION	MILEPOINT	LOCATION CODE (SHEET 2)	SIGN CODE	WIDTH (IN)	HEIGHT (IN)	SHEETING REMARKS	SIGN LEGEND	NEW SIGNS "A"	NEW SIGNS "B"	EXISTING SIGNS RETAIN	EXISTING SIGNS SALVAGE FROM	EXISTING SIGNS SALVAGE TO	EXISTING SIGNS REMOVE	EXIST POST RETAIN	EXIST POST REMOVE	NUMBER OF NEW POSTS	SQUARE STEEL (IN) 1.75 (LB / FT) 1.88	SQUARE STEEL (IN) 2.00 (LB / FT) 2.42	SQUARE STEEL (IN) 2.50 (LB / FT) 3.35	FOUNDATION	TUBULAR STEEL Ø (IN) 3.00 (LB / FT) 7.60	TUBULAR STEEL Ø (IN) 3.50 (LB / FT) 9.00	TUBULAR STEEL Ø (IN) 4.00 (LB / FT) 10.80	TUBULAR STEEL Ø (IN) 5.00 (LB / FT) 14.60	SIGN FRAME REQUIRED	REMARKS	SIGN DETAIL LOCATION SHSM	SIGN DETAIL LOCATION PROJECT SHEET #	SIGN DETAIL LOCATION STANDARD SHEET #
BERKSHIRE VT 105 EB							FY-FLUORESCENT YELLOW FYG-FLUORESCENT YELLOW GREEN																			"SHSM"-STANDARD HIGHWAY SIGNS AND MARKINGS			
EB	2.260	A	W2-1M	30	30								1		X													
		A	VW-205	30	30		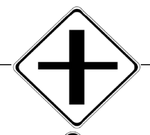						1															
		A	W2-1Mb	30	30			6.25								2		X									5	
		A	VW-205	30	30			6.25																		7	
EB	2.360	A	VW-092	30	30								1		X													
		A	VW-092	36	36			9.00								2		X									E-150
EB	2.450	C	VR-017	24	30								1		X													
		C	VR-017	24	30			5.00								1		X								RIVER RD (TH-46)		7	
EB	2.455	D	R1-1	30	30							3	~~1~~ 4		X													
		D	R1-1	30	30			6.25								1		X								RIVER RD (TH-46)	X		
EB	2.510	A	VW-092	30	30								1		X													
		A	VW-092	36	36			9.00								2		X									E-150
EB	2.535	A	OM-3R	12	36								1		X													
		A	OM-3R	12	36			3.00								1		X									X		
EB	2.570	B	OM-3L	12	36								1		X													
							SHEET TOTALS	44.75	0.00	0	0	~~0~~ 3	~~8~~ 11	0	0	9		135.0		0	0.0	0.0	0.0	0.0					
								SF	SF	EA	EA	EA	EA	EA	EA	EA		FT		EA	LB	LB	LB	LB					
							TOWN DIRECTIONAL TOTALS	235.4	0.0	0	0	0	53	0	0	40		600.0		0		0.0							

SIGN SUMMARY SHEET

VERMONT AGENCY OF TRANSPORTATION

PROJECT NAME: **St Albans - Berkshire**
PROJECT NUMBER: **STPG SIGN(36)**

FILE NAME: **BerkshireEB.xls**
PROJECT MANAGER: **A. Gamble**
DESIGNED BY: **T. Guazzoni**
BERKSHIRE EB SHEET 6

PLOT DATE: **5/17/2011**
DRAWN BY: **T. Guazzoni**
CHECKED **A. Gamble**
SHEET **99** OF **109**