DIRECTION	MILEPOINT	LOCATION CODE (SHEET 2)	SIGN CODE	WIDTH (IN)	HEIGHT (IN)	SHEETING REMARKS	SIGN LEGEND	NEW SIGNS		EXISTING SIGNS				EXIST POST		NUMBER OF NEW POSTS	SQUARE STEEL (IN)			TUBULAR STEEL Ø (IN)				SIGN FRAME REQUIRED	REMARKS	SIGN DETAIL LOCATION		
																	1.75	2.00	2.50	3.00	3.50	4.00	5.00					
																	(LB / FT)			(LB / FT)							
								"A"	"B"	RETAIN	SALVAGE FROM	SALVAGE TO	REMOVE	RETAIN	REMOVE		1.88	2.42	3.35	FOUNDATION	7.60	SLIP BASE ~~9.00~~	10.80	14.60			SHSM	PROJECT SHEET #	STANDARD SHEET #
BERKSHIRE VT105 WB							FY-FLUORESCENT YELLOW FYG-FLUORESCENT YELLOW GREEN																		"SHSM"-STANDARD HIGHWAY SIGNS AND MARKINGS			
		F	D1-1A	72	10								1															
		F	VD1-1A	72	12			6.00								2			X			2			INSTALL ON 2 1/2" SLIP BASES		4	
		F	VD1-1A	72	12		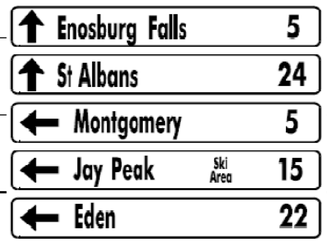	6.00																		4	
		F	VD1-1A	72	12			6.00																			4	
		F	VD1-1S	72	12			6.00																			4	
		F	VD1-1A	72	12			6.00																			4	
WB	1.080	F	M3-3	24	12		ROUTE MARKERS (9)						1		X													
		F	M1-5	30	24								1															
		F	M6-1	21	15								1															
		F	M3-4	24	12								1															
		F	M1-5	24	24								1															
		F	M6-3	21	15								1															
		F	M3-1	24	12								1															
		F	M1-5A	24	24								1															
		F	M6-1	21	15								1															
							SHEET TOTALS	30.00	0.00	0	0	0	10	0	0	2		30.0		0	0.0	~~0.0~~ 2	0.0	0.0					
								SF	SF	EA	EA	EA	EA	EA	EA	EA		FT		EA	LB	LB	LB	LB					
							TOWN DIRECTIONAL TOTALS	256.1	0.0	0	0	0	61	0	0	35		525.0		0		0.0							

SIGN SUMMARY SHEET

VERMONT AGENCY OF TRANSPORTATION

PROJECT NAME: **St Albans - Berkshire**
PROJECT NUMBER: **STPG SIGN(36)**
FILE NAME: **BerkshireWB.xls**
PROJECT MANAGER: **A. Gamble**
DESIGNED BY: **T. Guazzoni**
DRAWN BY: **T. Guazzoni**
CHECKED **A. Gamble**
PLOT DATE: **5/17/2011**
BERKSHIRE WB SHEET 4
SHEET **104** OF **109**