DIRECTION	MILEPOINT	LOCATION CODE (SHEET 2)	SIGN CODE	WIDTH (IN)	HEIGHT (IN)	SHEETING REMARKS	SIGN LEGEND	NEW SIGNS "A"	NEW SIGNS "B"	EXISTING SIGNS RETAIN	EXISTING SIGNS SALVAGE FROM	EXISTING SIGNS SALVAGE TO	EXISTING SIGNS REMOVE	EXIST POST RETAIN	EXIST POST REMOVE	NUMBER OF NEW POSTS	SQUARE STEEL (IN) 1.75 (LB / FT) 1.88	SQUARE STEEL (IN) 2.00 (LB / FT) 2.42	SQUARE STEEL (IN) 2.50 (LB / FT) 3.35	FOUNDATION	TUBULAR STEEL Ø (IN) 3.00 (LB / FT) 7.60	TUBULAR STEEL Ø (IN) 3.50 (LB / FT) SLIP BASE ~~9.00~~	TUBULAR STEEL Ø (IN) 4.00 (LB / FT) 10.80	TUBULAR STEEL Ø (IN) 5.00 (LB / FT) 14.60	SIGN FRAME REQUIRED	REMARKS	SIGN DETAIL LOCATION SHSM	SIGN DETAIL LOCATION PROJECT SHEET #	SIGN DETAIL LOCATION STANDARD SHEET #
BERKSHIRE VT105 WB							FY-FLUORESCENT YELLOW FYG-FLUORESCENT YELLOW GREEN																			"SHSM"-STANDARD HIGHWAY SIGNS AND MARKINGS			
		F	D1-1A	72	10								1																
		F	VD1-1A	72	12			6.00				I				2			X							INSTALL ON 2 1/2" SLIP BASES		4	
		F	VD1-1A	72	12		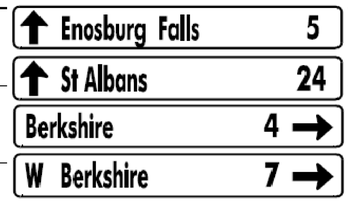	6.00																				4	
		F	VD1-1A	72	12			6.00																				4	
		F	VD1-1A	72	12			6.00																				4	
WB	0.980	F	M3-4	24	12		ROUTE MARKERS (6)						1		X														
		F	M1-5	30	24								1																
		F	M6-3	21	15								1																
		F	M3-1	24	12								1																
		F	M1-5A	30	24								1																
		F	M6-1	21	15								1																
		F	M3-4	24	12			2.00								2		X							#1B	GREEN ON WHITE	X	6	
		F	M1-5	30	24			5.00																					E-136B
		F	M6-3	21	15			2.19																		GREEN ON WHITE	X		
		F	M3-1	24	12			2.00																		BLACK ON WHITE	X		
							SHEET TOTALS	35.19	0.00	0	0	~~0~~ 1	7	0	0	4		60.0		0	0.0	~~0.0~~ 2	0.0	0.0					
								SF	SF	EA	EA	EA	EA	EA	EA	EA		FT		EA	LB	LB	LB	LB					
							TOWN DIRECTIONAL TOTALS	256.1	0.0	0	0	0	61	0	0	35		525.0		0		0.0							

SIGN SUMMARY SHEET

VERMONT AGENCY OF TRANSPORTATION

PROJECT NAME: **St Albans - Berkshire**
PROJECT NUMBER: **STPG SIGN(36)**

FILE NAME: **BerkshireWB.xls**
PROJECT MANAGER: **A. Gamble**
DESIGNED BY: **T. Guazzoni**
BERKSHIRE WB SHEET 6

PLOT DATE: **5/17/2011**
DRAWN BY: **T. Guazzoni**
CHECKED **A. Gamble**