TEMPORARY 4 INCH WHITE LINE, PAINT
DURABLE 4 INCH WHITE LINE (OPTION BID ITEM)
13+50 TO 18+50 SOLID LT & RT
13+50 TO 18+50 DASHED LT (LANE LINE)
13+50 TO 18+50 DASHED RT (LANE LINE)

TEMPORARY 4 INCH YELLOW LINE, PAINT
DURABLE 4 INCH YELLOW LINE (OPTION BID ITEM)
13+50 TO 18+47 SOLID LT & RT
18+47 TO 18+50 DOUBLE SOLID LT (ISLAND)
18+47 TO 18+50 DOUBLE SOLID RT (ISLAND)

TEMPORARY LETTER OR SYMBOL, PAINT
DURABLE LETTER OR SYMBOL (OPTION BID ITEM)
13+82 SOLID RT - "AHEAD" (2)

STEEL BEAM GUARDRAIL, GALVANIZED
13+50 TO 15+55 LT

ANCHOR FOR STEEL BEAM RAIL
15+55 LT

REMOVAL AND DISPOSAL OF GUARDRAIL
13+50 TO 15+54 LT

DELINEATOR WITH STEEL POST
15+55 LT

REMOVING SIGNS
AS SHOWN - 27

ERECTING SALVAGED SIGNS
AS SHOWN - 1

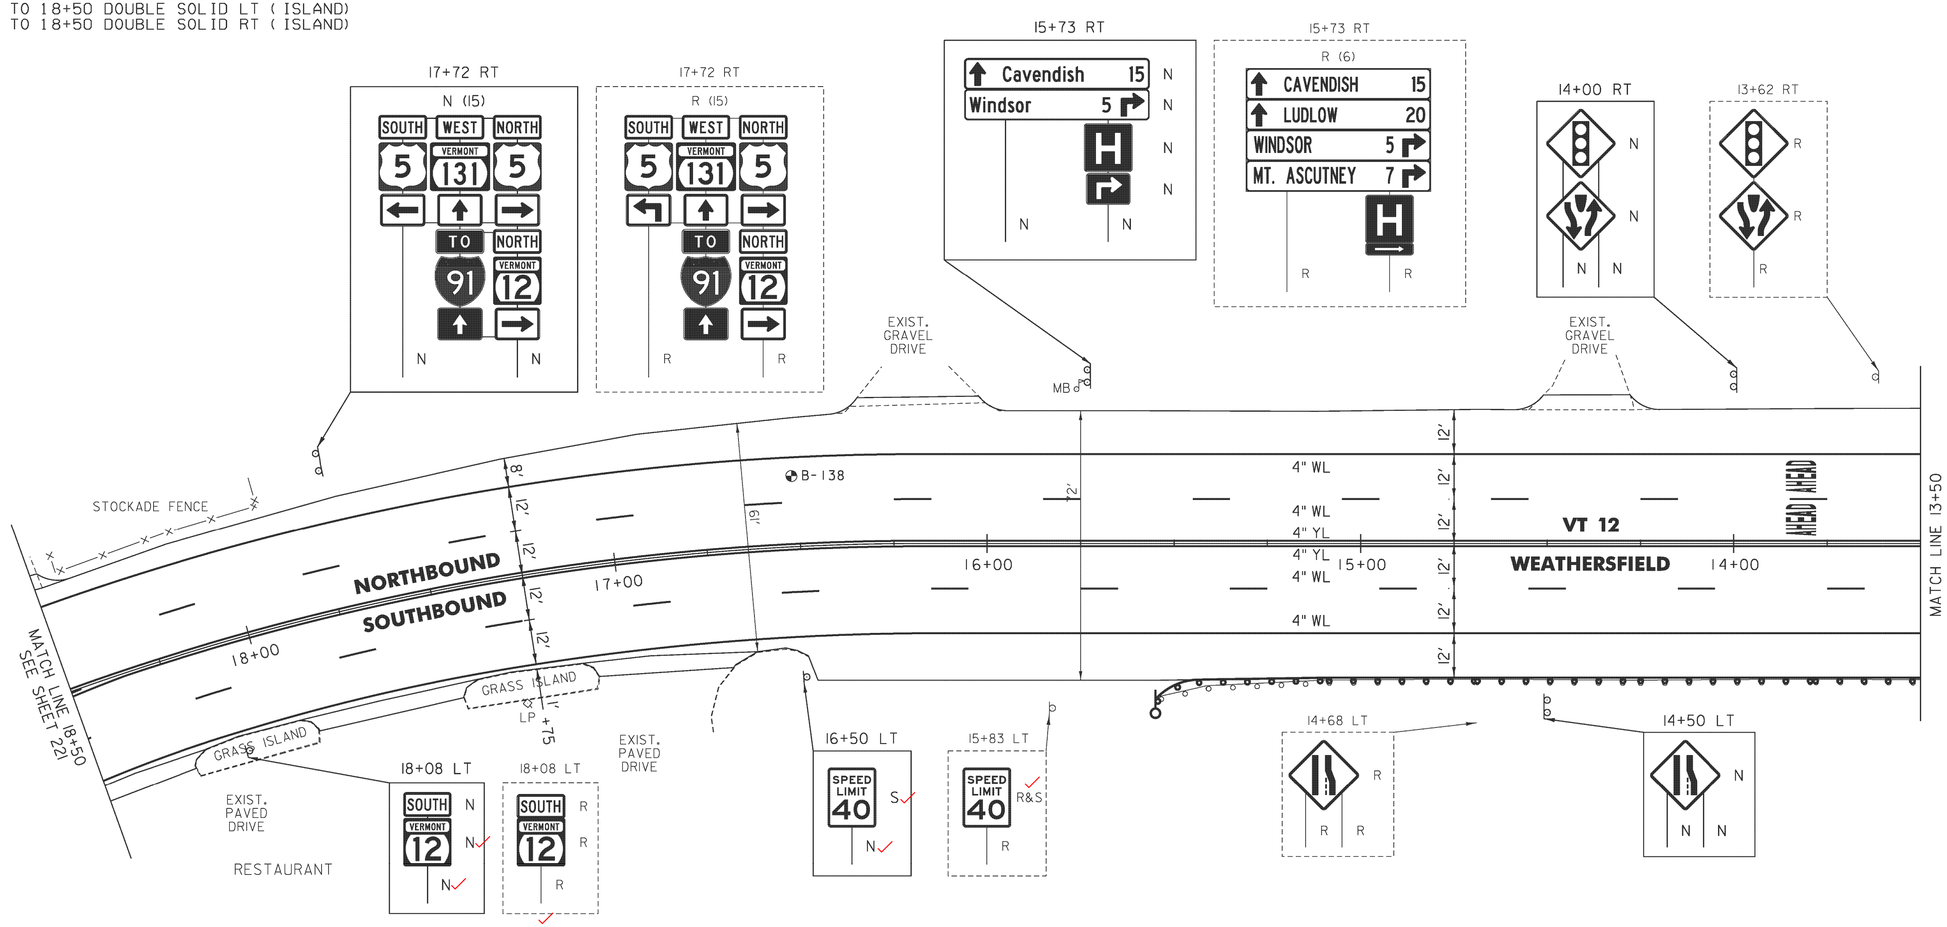

NOT TO SCALE

LEGEND

R	=	REMOVE EXISTING
S	=	SALVAGE
R&S	=	REMOVE AND SALVAGE
N	=	NEW
RET	=	RETAIN
B-B	=	BACK TO BACK
o—o	=	EXISTING GUARDRAIL
▬▬	=	PROPOSED GUARDRAIL
YL	=	YELLOW LINE
WL	=	WHITE LINE
—○	=	DELINEATOR

ROADWAY LAYOUT SHEET 7

PROJECT NAME: WEATHERSFIELD
PROJECT NUMBER: NH 2948(1)

FILE NAME: pl2b126.dgn
PROJECT LEADER: PTS
DESIGNED BY: NLL
IPARM FILE NAME: pl2b126_224

PLOT DATE: 2/7/2013
DRAWN BY: SNG
CHECKED BY: PTS
SHEET 224 OF 234