TEMPORARY 4 INCH WHITE LINE, PAINT
DURABLE 4 INCH WHITE LINE (OPTION BID ITEM)
8+50 TO 13+50 SOLID LT & RT
10+15 TO 13+50 DASHED RT (LANE LINE)
13+25 TO 13+50 DASHED LT (LANE LINE)

TEMPORARY 4 INCH YELLOW LINE, PAINT
DURABLE 4 INCH YELLOW LINE (OPTION BID ITEM)
8+50 TO 13+50 SOLID LT & RT

TEMPORARY LETTER OR SYMBOL, PAINT
DURABLE LETTER OR SYMBOL (OPTION BID ITEM)
11+37 SOLID LT - LANE REDUCTION ARROW
13+35 SOLID LT - LANE REDUCTION ARROW
13+42 SOLID RT - "SIGNAL" (2)

STEEL BEAM GUARDRAIL, GALVANIZED
12+55 TO 13+50 LT

ANCHOR FOR STEEL BEAM RAIL
12+55 LT

REMOVAL AND DISPOSAL OF GUARDRAIL
12+52 TO 13+50 LT

DELINEATOR WITH STEEL POST
12+55 LT

REMOVING SIGNS
AS SHOWN - 9

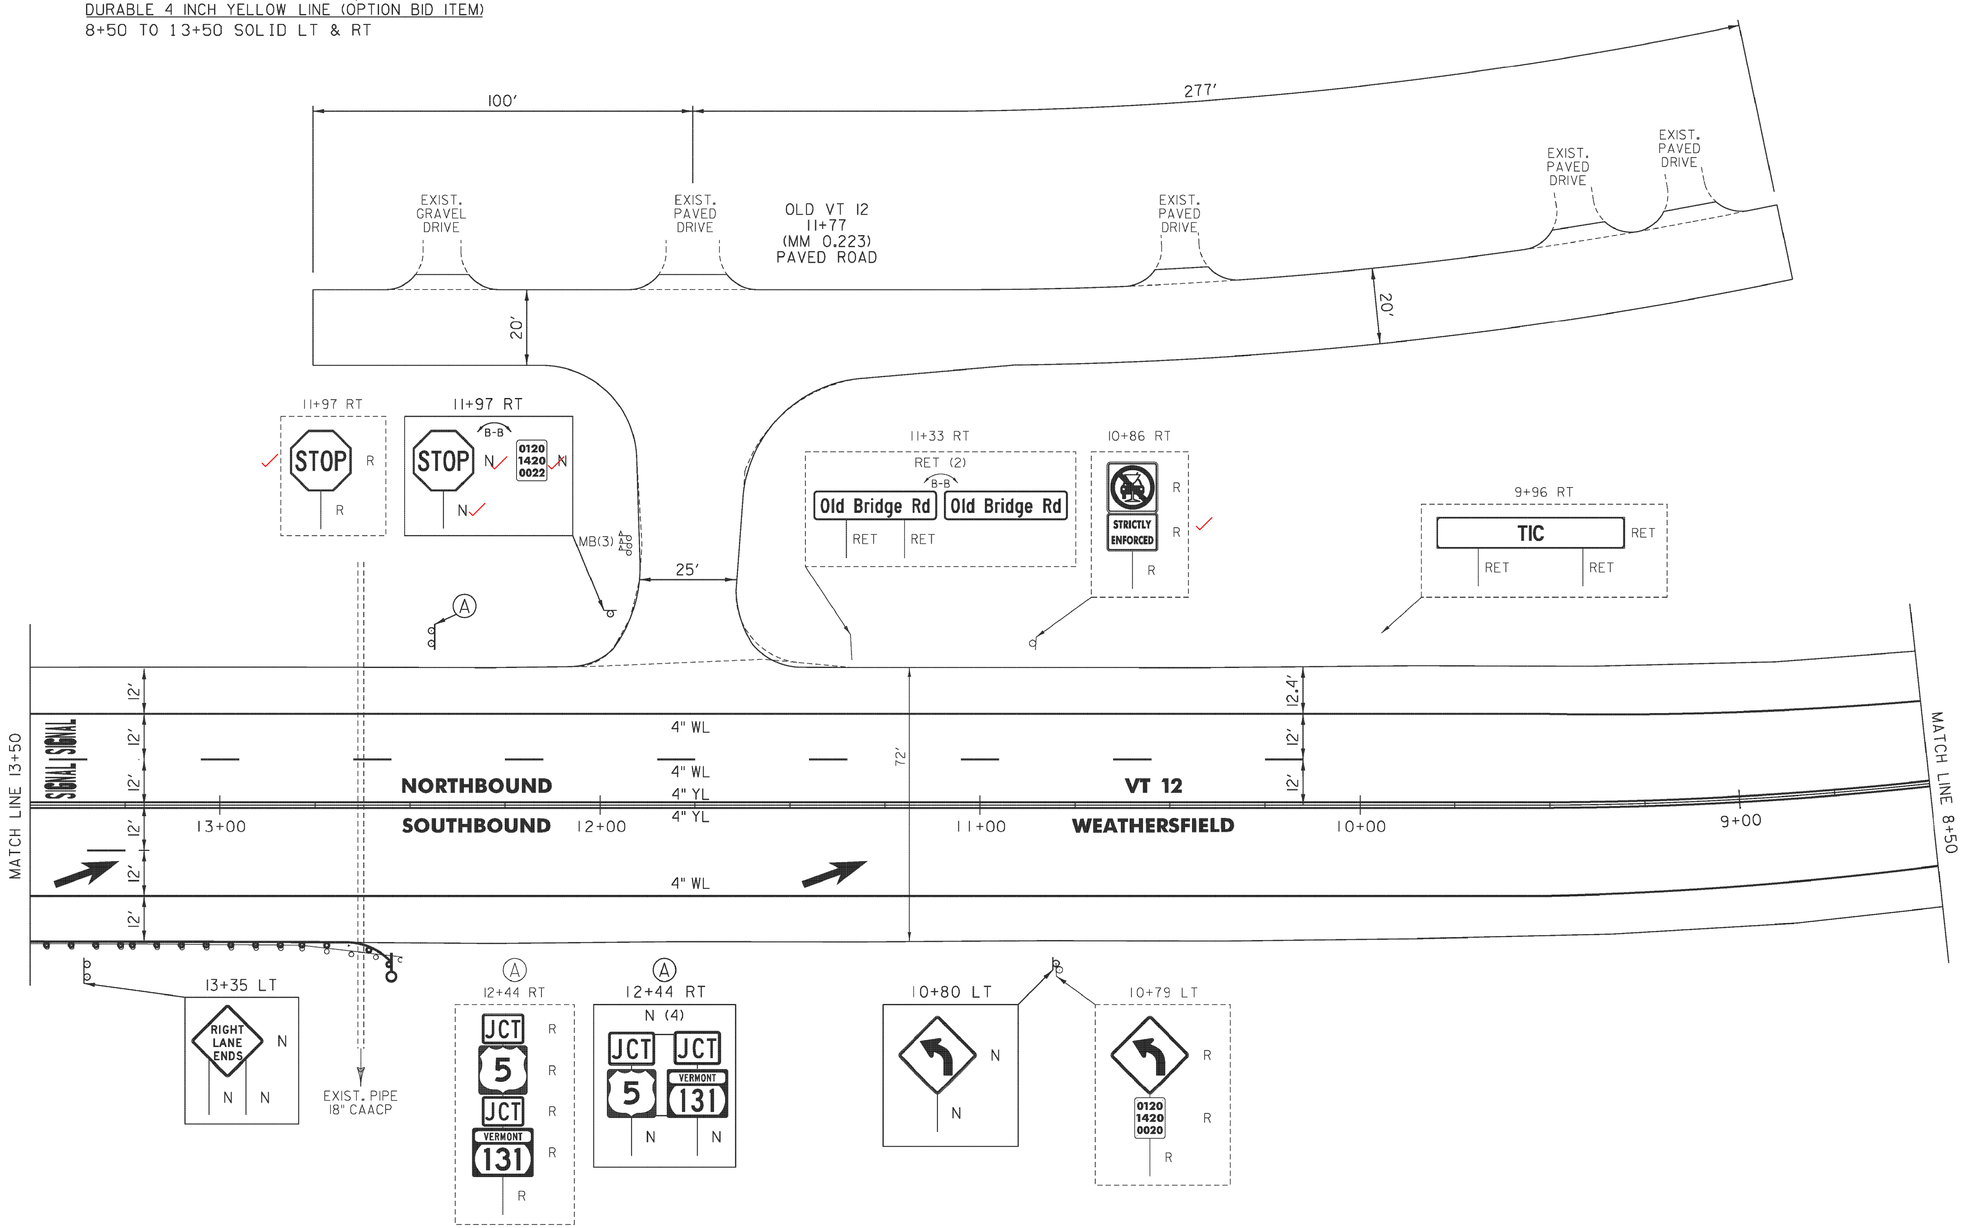

NOT TO SCALE

LEGEND

R	=	REMOVE EXISTING
S	=	SALVAGE
R&S	=	REMOVE AND SALVAGE
N	=	NEW
RET	=	RETAIN
B-B	=	BACK TO BACK
o—o	=	EXISTING GUARDRAIL
o—o	=	PROPOSED GUARDRAIL
YL	=	YELLOW LINE
WL	=	WHITE LINE
—○	=	DELINEATOR

ROADWAY LAYOUT SHEET 8

PROJECT NAME: WEATHERSFIELD
PROJECT NUMBER: NH 2948(1)

FILE NAME: pl2bl26.dgn
PROJECT LEADER: PTS
DESIGNED BY: NLL
IPARM FILE NAME: pl2Bl26_225

PLOT DATE: 2/7/2013
DRAWN BY: SNG
CHECKED BY: PTS
SHEET 225 OF 234