TEMPORARY 4" WHITE LINE, PAINT
DURABLE 4" WHITE LINE (OPTION BID ITEM)
251+50 TO 262+50 SOLID LT
251+50 TO 252+83 SOLID RT
252+83 TO 253+11 SOLID RT (TH 9)
253+32 TO 253+45 SOLID RT (TH 9)
253+45 TO 262+50 SOLID RT

TEMPORARY 4" YELLOW LINE, PAINT
DURABLE 4" YELLOW LINE (OPTION BID ITEM)
251+50 TO 252+98 SOLID LT & RT
253+17 TO 253+21 DOUBLE SOLID RT (TH 9)
253+38 TO 262+50 SOLID LT & RT

TEMPORARY 24" STOP BAR, PAINT
DURABLE 24" STOP BAR (OPTION BID ITEM)
253+18 TO 253+32 RT (TH 9)

TEMPORARY LETTER OR SYMBOL, PAINT
DURABLE LETTER OR SYMBOL (OPTION BID ITEM)
253+25 RT - "STOP" (TH 9)

STEEL BEAM GUARDRAIL, GALVANIZED
253+34 TO 258+75 LT

STEEL BEAM GUARDRAIL, GALVANIZED W/8 FEET POSTS
256+55 TO 259+55 RT

ANCHOR FOR STEEL BEAM RAIL
253+34 LT
256+55 RT
258+75 LT
259+55 RT

REMOVAL AND DISPOSAL OF GUARDRAIL
253+43 TO 258+77 LT
256+54 TO 259+55 RT

DELINEATOR WITH STEEL POST
253+34 LT
256+55 RT
258+75 LT
259+55 RT

RELOCATE MAILBOX, SINGLE SUPPORT
259+50 LT

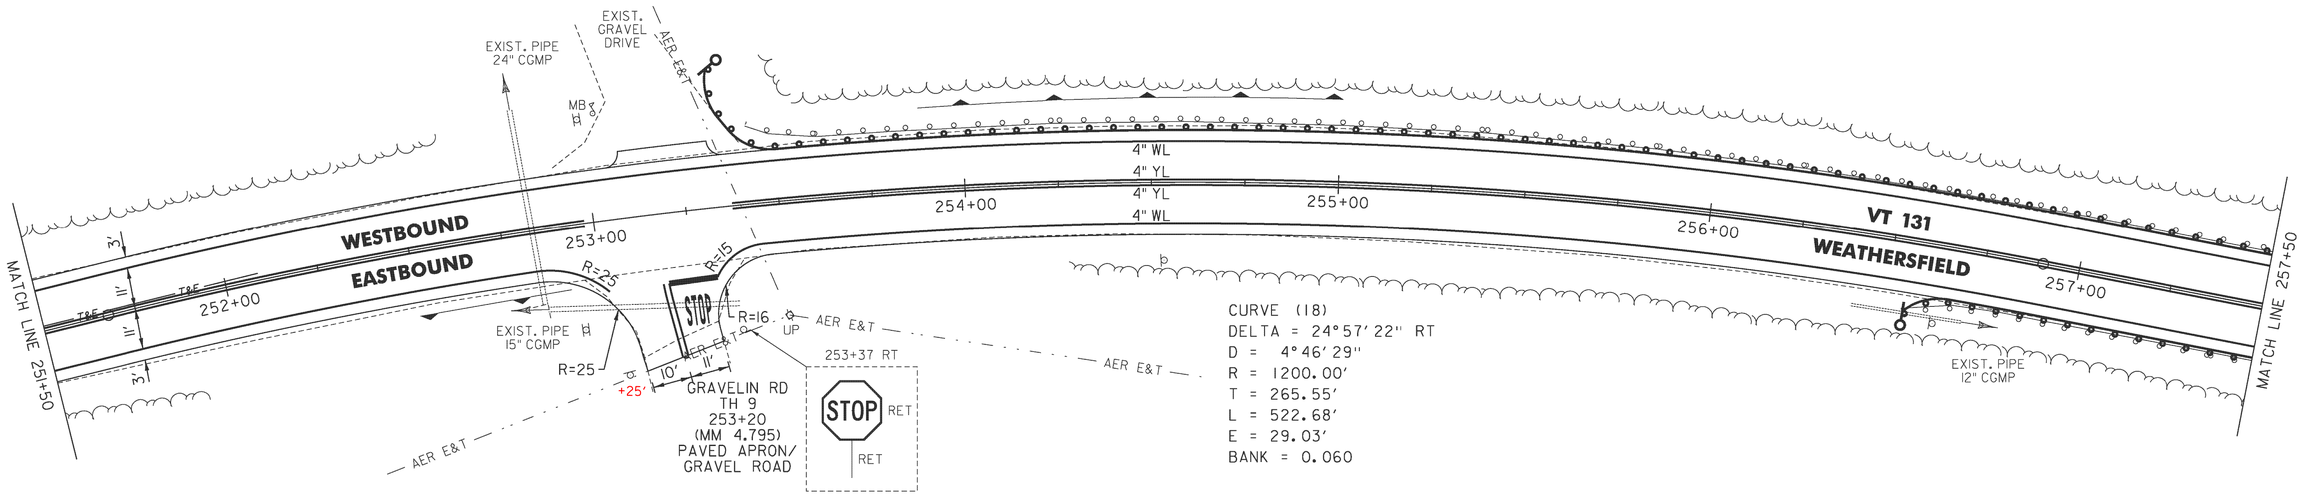

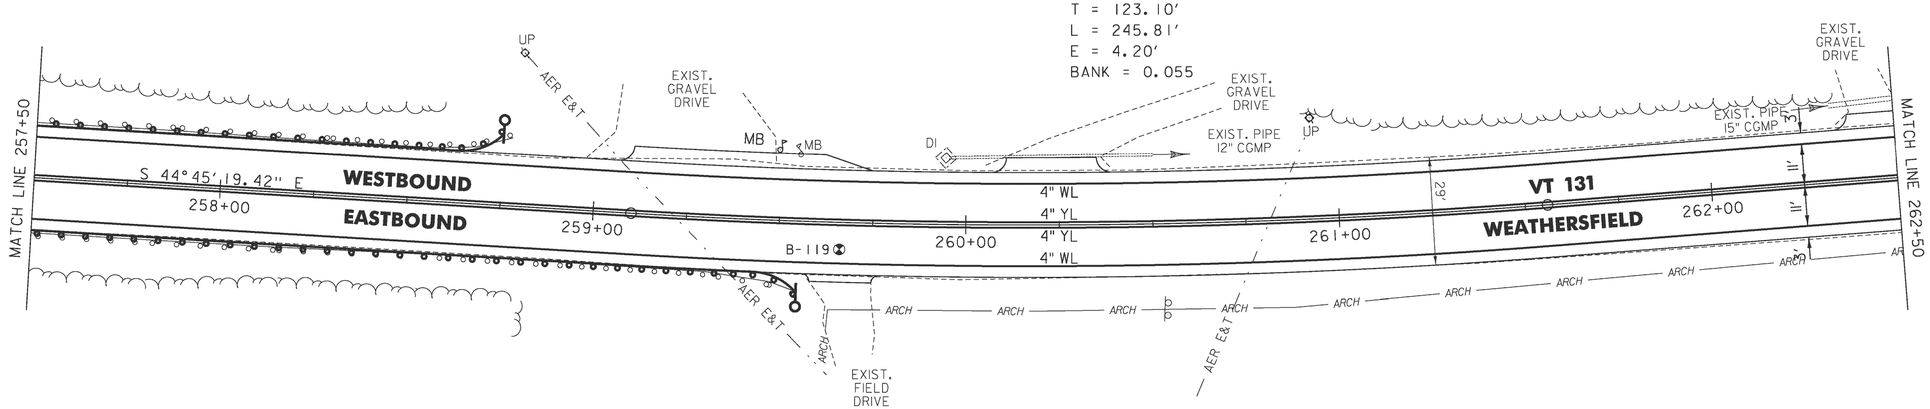

LEGEND

R	=	REMOVE EXISTING
S	=	SALVAGE
R&S	=	REMOVE AND SALVAGE
N	=	NEW
RET	=	RETAIN
B-B	=	BACK TO BACK
	=	EXISTING GUARDRAIL
	=	PROPOSED GUARDRAIL
YL	=	YELLOW LINE
WL	=	WHITE LINE
	=	DELINEATOR
	=	UNDERDRAIN
	=	BORING

NOT TO SCALE

ROADWAY LAYOUT SHEET 18

PROJECT NAME: WEATHERSFIELD
PROJECT NUMBER: STP 2913(I)

FILE NAME: 10c228.dgn
PROJECT LEADER: PTS
DESIGNED BY: NLL
IPARM FILE NAME: pl0C228_51

PLOT DATE: 3/7/2013
DRAWN BY: WWG
CHECKED BY: PTS
SHEET 51 OF 234