STATE OF VERMONT
AGENCY OF TRANSPORTATION

TRAFFIC SIGN SUMMARY SHEET #2

SHSM = FHWA 2004 STANDARD HIGHWAY SIGNS AND MARKINGS BOOK AND THE 2012 SUPPLEMENT TO THE 2004 EDITION

MILEMARKER, STATION, OR SIGN NUMBER	SIGN LEGEND	SIGN DIMENSIONS			NEW & SALVAGED SIGNS				EXIST POST		NEW SIGN POSTS																	REMARKS	SIGN DETAIL		
		EA	WIDTH (in)	HEIGHT (in)	"A"	"B"	SALV SIGN	SALV TIS	RETAIN	SALVAGE	NO. OF POSTS	SQUARE STEEL (in)			ANCHOR	SLEEVE	TUBULAR ALUMINUM Ø (in)			FOUND-ATION	TUBULAR STEEL Ø (in)				W-SHAPE STEEL				SIGN FRAME REQUIRED		SHSM	DETAIL ON SHEET NUMBER	STD. SHEET NUMBER
												1.75	2.0	2.5			3.0	4.0	4.0 MOD		3.0	3.5	4.0	5.0	FTG. SIZE		WEIGHT	POST SIZE					
												lb/ft					lb/ft				lb/ft				24"	30"							
												1.88	2.42	3.35			1.3	1.7	1.7		7.6	9.0	10.8	14.6									
392+61 RT	LAVIGNE RD						1✓				1		14.0 X		X																		
	STOP 1310 1420 0744						1✓ 1✓																					BACK TO BACK					
396+40 LT	STATE LAW						1✓				1		16.75 X		X																		
	SPEED LIMIT 50						1✓																										
	UNLESS OTHERWISE POSTED						1✓																										
407+02 LT							1✓				1		14.0 X		X																		
410+03 RT	SPEED LIMIT 40						1✓				1		14.5 X		X																		
418+44 RT							1✓				1		15.5 X		X																		
282+85 LT	BR #14						1✓																										
	SUBTOTAL SHEET 67 SUBTOTAL SHEET 68				17.17✓		~~11~~ 13 ~~9~~ 10						~~165~~ 147.5 ~~75~~ 74.75																				
	ROUNDING				~~0.83~~																												
	PROJECT TOTALS				SF ~~18~~ 17.17	SF	EA. ~~20~~ 23	SF				FT ~~240~~ 222.25					LB			EA.	LB				EA.	EA.	LB						

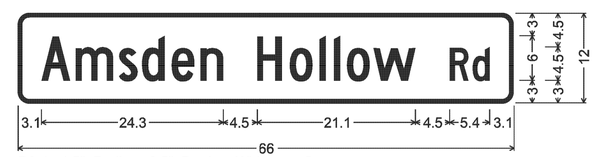

D3-1; 1.5" Radius, 0.5" Border, White on Green;
[Amsden Hollow] C 2K; [Rd] C 2K;

NOTE
SEE SIGN GENERAL NOTES ON SHEET 234.

FINAL POST LENGTHS ARE TO BE DETERMINED IN THE FIELD. POST SIZES ARE COMPUTED BASED ON INFORMATION FURNISHED ON THE STANDARD SHEETS AND VTRANS "SIGN POST DESIGN GUIDELINE."

											FT	FT	FT		EA	LB	LB	LB		LB	LB	LB	LB								
												~~240~~ 222.25																			

TRAFFIC SIGN SUMMARY SHEET #2

PROJECT NAME: WEATHERSFIELD
PROJECT NUMBER: STP 2913(1)

FILE NAME: z10c228s_tss.dgn
PROJECT LEADER: PTS
DESIGNED BY: NLL
IPARM FILE NAME: p10C228_68

PLOT DATE: 2/7/2013
DRAWN BY: SNG
CHECKED BY: PTS
SHEET 68 OF 234