DIRECTION	MILEPOINT	LOCATION CODE (SHEET 2)	SIGN CODE	WIDTH (IN)	HEIGHT (IN)	SHEETING REMARKS	SIGN LEGEND	NEW SIGNS "A"	NEW SIGNS "B"	EXISTING SIGNS RETAIN	EXISTING SIGNS SALVAGE FROM	EXISTING SIGNS SALVAGE TO	EXISTING SIGNS REMOVE	EXIST POST RETAIN	EXIST POST REMOVE	NUMBER OF NEW POSTS	SQUARE STEEL (IN) 1.75 (LB / FT) 1.88	SQUARE STEEL (IN) 2.00 (LB / FT) 2.42	SQUARE STEEL (IN) 2.50 (LB / FT) 3.35	FOUNDATION	TUBULAR STEEL Ø (IN) 3.00 (LB / FT) 7.60	TUBULAR STEEL Ø (IN) 3.50 (LB / FT) 9.00	TUBULAR STEEL Ø (IN) 4.00 (LB / FT) 10.80	TUBULAR STEEL Ø (IN) 5.00 (LB / FT) 14.60	SIGN FRAME REQUIRED	REMARKS	SIGN DETAIL DETAIL IN SHS	SIGN DETAIL DETAIL ON SHEET NUMBER	SIGN DETAIL DETAIL ON STD SHEET NUMBER
MORRISTOWN WB							FY-FLUORESCENT YELLOW FYG-FLUORESCENT YELLOW GREEN																			"SHS"-STANDARD HIGHWAY SIGNS			
		F	D1-1A	72	10								1															
		F	D1-1A	72	10								1															
		F	D1-1A	72	10								1															
		F	D9-2	24	24								1															
		F	D9-2A	24	6								1															
		F	D1-1A	72	12		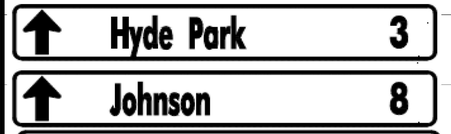	6.00								2		X									4	
		F	D1-1A	72	12			6.00																			4	
		F	D1-1A	72	12			6.00																			4	
		F	D1-1A	72	12			6.00																	WATERBURY NOT REPLACED		4	
		F	D9-2	24	24			4.00																	INSTALL ON LEFT POST	X		
		F	M6-1	24	6			1.00																	WHITE ON BLUE	X		
WB	2.570	F	M3-4	24	12								1		X													
		F	M1-5A	24	24								1															
		F	M4-5	24	12								1															
		F	M3-3	24	12								1															
							SHEET TOTALS	29.00	0.00	0	0	0	9	0	0	2		30										
								SF	SF	EA	EA	EA	EA	EA	EA	EA		FT										
							TOWN DIRECTIONAL TOTALS	203.0	0.0	29.0	14.0	14.0	51	0.0	0.0	28		420.0										

SIGN SUMMARY SHEET

VERMONT AGENCY OF TRANSPORTATION

PROJECT NAME: STATEWIDE NORTHEAST
PROJECT NUMBER: STPG SIGN (29)

FILE NAME: MORRISTOWN WB
PROJECT MANAGER: A. GAMBLE
DESIGNED BY: D.CROSSLEY
MORRISTOWN VT 15 WB 3

PLOT DATE: 8/23/2010
DRAWN BY: D.CROSSLEY
CHECKED BY: A. GAMBLE