DIRECTION	MILEPOINT	LOCATION CODE (SHEET 2)	SIGN CODE	WIDTH (IN)	HEIGHT (IN)	SHEETING REMARKS	SIGN LEGEND	NEW SIGNS "A"	NEW SIGNS "B"	EXISTING SIGNS RETAIN	EXISTING SIGNS SALVAGE FROM	EXISTING SIGNS SALVAGE TO	EXISTING SIGNS REMOVE	EXIST POST RETAIN	EXIST POST REMOVE	NUMBER OF NEW POSTS	SQUARE STEEL (IN) 1.75 (LB / FT) 1.88	SQUARE STEEL (IN) 2.00 (LB / FT) 2.42	SQUARE STEEL (IN) 2.50 (LB / FT) 3.35	FOUNDATION	TUBULAR STEEL Ø (IN) 3.00 (LB / FT) 7.60	TUBULAR STEEL Ø (IN) 3.50 (LB / FT) 9.00	TUBULAR STEEL Ø (IN) 4.00 (LB / FT) 10.80	TUBULAR STEEL Ø (IN) 5.00 (LB / FT) 14.60	SIGN FRAME REQUIRED	REMARKS	SIGN DETAIL: DETAIL IN SHS	SIGN DETAIL: DETAIL ON SHEET NUMBER	SIGN DETAIL: DETAIL ON STD SHEET NUMBER
BRADFORD US5 NB							FY-FLUORESCENT YELLOW FYG-FLUORESCENT YELLOW GREEN																			"SHS"-STANDARD HIGHWAY SIGNS			
0050, US5																												
NB	0.000	C	VD-024	60	7.5								1		X													
		C	VD-024	72	12		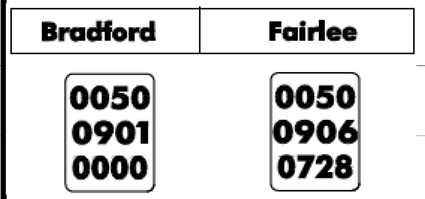	6.00								2		X									4	
		C	VD-700	6	10			0.42																				4	
		C	VD-700	6	10			0.42																				4	
NB	0.137	A	VW-133	30	30		HIDDEN DRIVE LEFT				1				X													
NB	0.168	A	S3-1	30	30		SCHOOL BUS STOP AHEAD						1		X													
NB	0.213	A	VW-133	30	30		HIDDEN DRIVE LEFT					1				1		X								INSTALL 420' +/- NORTH OF ORIGINAL LOCATION			E-154
NB	0.285	A	W10-2R	36	36		INTERSECTION WARNING W/ RR TRACKS			1				X														
NB	0.354	C	VR-017	24	30								1		X											CHARLES FIELD RD TH-40			
		C	VR-017	24	30			5.00								1		X										E-141
NB	0.362	D	R1-1	30	30		STOP			1				X												CHARLES FIELD RD TH-40			
NB	1.109	A	VD-062BC	74.75	16		TRAVEL INFO			1				X														
		A	VD-062C	74.75	16		TRAVEL INFO			1																		
NB	1.160	A	R2-5A	24	30								1		X													
							SHEET TOTALS	11.84	0.00	4	1	1	4	0	0	4		60										
								SF	SF	EA	EA	EA	EA	EA	EA	EA		FT										
							TOWN DIRECTIONAL TOTALS	453.8	0.0	15.0	6.0	6.0	90	0.0	0.0	69		1035.0										

SIGN SUMMARY SHEET

VERMONT AGENCY OF TRANSPORTATION

PROJECT NAME: STATEWIDE NORTHEAST
PROJECT NUMBER: STPG SIGN (29)

FILE NAME: BRADFORD US 5 NB
PROJECT MANAGER: A. GAMBLE
DESIGNED BY: D. CROSSLEY
BRADFORD US 5 NB 1

PLOT DATE: 8/23/2010
DRAWN BY: D. CROSSLEY
CHECKED BY: A. GAMBLE
SHEET 105 OF 138