DIRECTION	MILEPOINT	LOCATION CODE (SHEET 2)	SIGN CODE	WIDTH (IN)	HEIGHT (IN)	SHEETING REMARKS	SIGN LEGEND	NEW SIGNS "A"	NEW SIGNS "B"	EXISTING SIGNS RETAIN	EXISTING SIGNS SALVAGE FROM	EXISTING SIGNS SALVAGE TO	EXISTING SIGNS REMOVE	EXIST POST RETAIN	EXIST POST REMOVE	NUMBER OF NEW POSTS	SQUARE STEEL (IN) 1.75 (LB / FT) 1.88	SQUARE STEEL (IN) 2.00 (LB / FT) 2.42	SQUARE STEEL (IN) 2.50 (LB / FT) 3.35	FOUNDATION	TUBULAR STEEL Ø (IN) 3.00 (LB / FT) 7.60	TUBULAR STEEL Ø (IN) 3.50 (LB / FT) 9.00	TUBULAR STEEL Ø (IN) 4.00 (LB / FT) 10.80	TUBULAR STEEL Ø (IN) 5.00 (LB / FT) 14.60	SIGN FRAME REQUIRED	REMARKS	SIGN DETAIL: DETAIL IN SHS	SIGN DETAIL: DETAIL ON SHEET NUMBER	SIGN DETAIL: DETAIL ON STD SHEET NUMBER
BRADFORD US5 SB							FY-FLUORESCENT YELLOW FYG-FLUORESCENT YELLOW GREEN																			"SHS"-STANDARD HIGHWAY SIGNS			
		F	M6-1	21	15		RIGHT --->						1																
		F	D1-1A	72	12		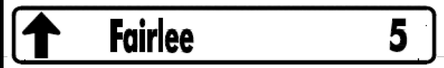	6.00								2		X									4	
		F	D1-1M	72	12			6.00																			4	
		F	D1-1A	72	12		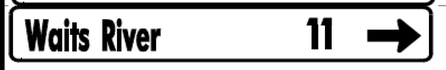	6.00																			4	
SB	1.490	F	VR-922L	36	30		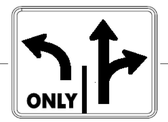						1		X														
		F	VR-922L	36	30			7.50								1		X									6	
SB	1.455	F	M3-3	24	12			2.00								2			X							(2) #2	BLACK ON WHITE	X		
		F	M1-4	24	24			4.00																			INSTALL THIS ASSEMBLY BEHIND GUARD RAIL AT BEGINNING OF CURVED CURB	X		
		F	M6-3	21	15			2.19																			BLACK ON WHITE	X		
		F	M3-3	24	12			2.00																			GREEN ON WHITE	X		
		F	M1-5	24	24			4.00																						E-136B
		F	M6-1	21	15			2.19																			GREEN ON WHITE	X		
		F	M4-5	24	12			2.00																			WHITE ON BLUE	X		
		F	M1-1	24	24			4.00																				X		
		F	M6-1	21	15			2.19																			WHITE ON BLUE	X		
							SHEET TOTALS	50.07	0.00	0	0	0	2	0	0	5		75											
								SF	SF	EA	EA	EA	EA	EA	EA	EA		FT											
							TOWN TOTALS	531.1	0.0	13.0	4.0	4.0	95	0.0	0.0	85		1275.0											

SIGN SUMMARY SHEET

VERMONT AGENCY OF TRANSPORTATION

PROJECT NAME: **STATEWIDE NORTHEAST**
PROJECT NUMBER: **STPG SIGN (29)**

FILE NAME: **BRADFORD US5 SB**
PROJECT MANAGER: **A. GAMBLE**
DESIGNED BY: **D. CROSSLEY**
BRADFORD US 5 SB 13

PLOT DATE: **8/18/2010**
DRAWN BY: **D. CROSSLEY**
CHECKED BY: **A. GAMBLE**
SHEET **132** OF **138**