DIRECTION	MILEPOINT	LOCATION CODE (SHEET 2)	SIGN CODE	WIDTH (IN)	HEIGHT (IN)	SHEETING REMARKS	SIGN LEGEND	NEW SIGNS "A"	NEW SIGNS "B"	EXISTING SIGNS RETAIN	EXISTING SIGNS SALVAGE FROM	EXISTING SIGNS SALVAGE TO	EXISTING SIGNS REMOVE	EXIST POST RETAIN	EXIST POST REMOVE	NUMBER OF NEW POSTS	SQUARE STEEL (IN) 1.75 (LB / FT) 1.88	SQUARE STEEL (IN) 2.00 (LB / FT) 2.42	SQUARE STEEL (IN) 2.50 (LB / FT) 3.35	TUBULAR STEEL Ø (IN) FOUNDATION	TUBULAR STEEL Ø (IN) 3.00 (LB / FT) 7.60	TUBULAR STEEL Ø (IN) 3.50 (LB / FT) 9.00	TUBULAR STEEL Ø (IN) 4.00 (LB / FT) 10.80	TUBULAR STEEL Ø (IN) 5.00 (LB / FT) 14.60	SIGN FRAME REQUIRED	REMARKS	SIGN DETAIL: DETAIL IN SHS	SIGN DETAIL: DETAIL ON SHEET NUMBER	SIGN DETAIL: DETAIL ON STD SHEET NUMBER
WILLISTON NORTHBOUND							FY-FLUORESCENT YELLOW FYG-FLUORESCENT YELLOW GREEN																			"SHS"-STANDARD HIGHWAY SIGNS			
		A	W3-3	36	36		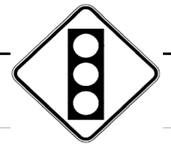	9.00								2		X								X		
NB	4.725	A	VD-062B	72	16		BUSINESS SIGN			1				X														
		A	VD-062AL	72	16		BUSINESS SIGN			1																		
		A	VD-062B	72	16		BUSINESS SIGN			1																		
NB	4.735	A	VR-063L	30	30								1		X													
		A	R3-7L	30	30			6.25								1		X								X		
NB	4.765	A	VR-922L	30	24		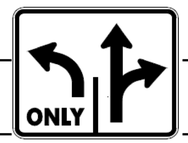	5.00								1		X								INSTALL 25' +/- SOUTH OF EXISTING LOCATION			E-145A
NB	4.770	A	VR-922L	30	30		LEFT ONLY/THRU & RIGHT						1		X													
NB	4.780	A	VR-004	18	24								1		X													
		A	W11-2	30	30	FYG		6.25								1		X								X		
		A	W16-7P	24	12	FYG		2.00																		X		
NB	4.810	A	R1-1	30	30								~~1~~		X													
		A	R1-1	30	30			6.25								1		X								X		
NB	4.783	A	OM1-1	18	18		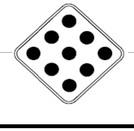 x3	7.5					3 ~~1~~		X													
		A	OM1-1	18	18			2.25 2.25 2.25					1			3 ~~1~~		X								X		
SIGN SUMMARY SHEET							SHEET TOTALS	49.00 ~~37.00~~	0.00	3	0	0	7 ~~5~~	0	0	7		105									
VERMONT AGENCY OF TRANSPORTATION								SF	SF	EA	EA	EA	EA	EA	EA	EA		FT									
							TOWN DIRECTIONAL TOTALS	434.7	0.0	26.0	1.0	1.0	90	0.0	0.0	69		1035.0									

PROJECT NAME: **Statewide - Northwest Region**
PROJECT NUMBER: **STPG SIGN(30)**

FILE NAME: **Williston NB.xls** PLOT DATE: **8/11/2010**
PROJECT MANAGER: **A. Gamble** DRAWN BY: **T. Guazzoni**
DESIGNED BY: **T. Guazzoni** CHECKED BY: **A. Gamble**
WILLISTON VT 2A NB SHEET 11 SHEET **19** OF **131**