DIRECTION	MILEPOINT	LOCATION CODE (SHEET 2)	SIGN CODE	WIDTH (IN)	HEIGHT (IN)	SHEETING REMARKS	SIGN LEGEND	NEW SIGNS "A"	NEW SIGNS "B"	EXISTING SIGNS RETAIN	EXISTING SIGNS SALVAGE FROM	EXISTING SIGNS SALVAGE TO	EXISTING SIGNS REMOVE	EXIST POST RETAIN	EXIST POST REMOVE	NUMBER OF NEW POSTS	SQUARE STEEL (IN) 1.75 (LB / FT) 1.88	SQUARE STEEL (IN) 2.00 (LB / FT) 2.42	SQUARE STEEL (IN) 2.50 (LB / FT) 3.35	TUBULAR STEEL Ø (IN) FOUNDATION	TUBULAR STEEL Ø (IN) 3.00 (LB / FT) 7.60	TUBULAR STEEL Ø (IN) 3.50 (LB / FT) 9.00	TUBULAR STEEL Ø (IN) 4.00 (LB / FT) 10.80	TUBULAR STEEL Ø (IN) 5.00 (LB / FT) 14.60	SIGN FRAME REQUIRED	REMARKS	SIGN DETAIL: DETAIL IN SHS	SIGN DETAIL: DETAIL ON SHEET NUMBER	SIGN DETAIL: DETAIL ON STD SHEET NUMBER
WILLISTON SOUTHBOUND							FY-FLUORESCENT YELLOW FYG-FLUORESCENT YELLOW GREEN																			"SHS"-STANDARD HIGHWAY SIGNS			
		F	M3-3	24	12			2.00								1		X							GREEN ON WHITE SHEETING	X		
		F	M1-5	24	24			4.00																				E-136B
SB	3.272	F	VW-544	30	30			6.25								1		X							INSTALL 200' +/- SOUTH OF ROUTE MARKER SIGN		6	
SB	3.232	F	VD-502SP	72	10		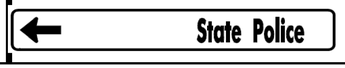	5.00								2		X							INSTALL 410' +/- SOUTH OF ROUTE MARKER SIGN		6	
			PROJECT RESUMES AT BEYOND INTERSTATE 89 INTERCHANGE																									
SB	2.400	F	R2-1	24	30			5.00								1		X							INSTALL 400' +/- NORTH OF INTERSECTION WITH WALKER HILL RD	X		
SB	2.327	G	VR-017	24	30								1		X													
		G	VR-017	24	30			5.00								1		X							WALKER HILL RD (TH-18)			E-141
SB	2.321	H	R1-1	30	30								1		X													
		H	R1-1	30	30			6.25				I				1		X							WALKER HILL RD (TH-18)	X		
SB	2.11	G	W1-7	48	24		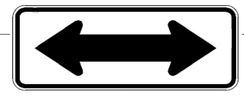						1		X													
		G	W1-7	48	24			8.00								2		X								X		
SB	2.085	F	W1-4R	30	30		RIGHT REVERSE CURVE				1		I	X											SALVAGE SIGN TO MP 2.05			
		F	R2-1	24	30			~~5.00~~ 0																		X		
SB	2.05	F	R2-1	24	30		SPEED LIMIT 40						~~1~~	X														
							SHEET TOTALS	~~46.50~~ 41.50	0.00	0	1	~~0~~ I	4	0	0	9		135										
								SF	SF	EA	EA	EA	EA	EA	EA	EA		FT										
							TOWN DIRECTIONAL TOTALS	472.7	0.0	20.0	1.0	1.0	84	0.0	0.0	67		1005.0										

SIGN SUMMARY SHEET

VERMONT AGENCY OF TRANSPORTATION

PROJECT NAME: **Statewide - Northwest Region**
PROJECT NUMBER: **STPG SIGN(30)**

FILE NAME: **Williston SB.xls**
PROJECT MANAGER: **A. Gamble**
DESIGNED BY: **T. Guazzoni**
WILLISTON VT 2A SB SHEET 12

PLOT DATE: **8/11/2010**
DRAWN BY: **T. Guazzoni**
CHECKED BY: **A. Gamble**
SHEET **34** OF **131**