DIRECTION	MILEPOINT	LOCATION CODE (SHEET 2)	SIGN CODE	WIDTH (IN)	HEIGHT (IN)	SHEETING REMARKS	SIGN LEGEND	NEW SIGNS		EXISTING SIGNS				EXIST POST		NUMBER OF NEW POSTS	SQUARE STEEL (IN)			TUBULAR STEEL Ø (IN)				SIGN FRAME REQUIRED	REMARKS	SIGN DETAIL		
								"A"	"B"	RETAIN	SALVAGE FROM	SALVAGE TO	REMOVE	RETAIN	REMOVE		1.75 (LB / FT) 1.88	2.00 (LB / FT) 2.42	2.50 (LB / FT) 3.35	FOUNDATION	3.00 (LB / FT) 7.60	3.50 (LB / FT) 9.00	4.00 (LB / FT) 10.80	5.00 (LB / FT) 14.60			DETAIL IN SHS	DETAIL ON SHEET NUMBER	DETAIL ON STD SHEET NUMBER
ADDISON WESTBOUND							FY-FLUORESCENT YELLOW FYG-FLUORESCENT YELLOW GREEN																		"SHS"-STANDARD HIGHWAY SIGNS			
WB	11.119	F	D2-1	72	12		ADDISON 3			1				X														
		F	M3-4S	24	12		WEST			1																		
		F	M1-5	24	24		VERMONT 17			1																		
WB	11.052	F	R2-1	24	30		SPEED LIMIT 45			1				X														
WB	10.750	F	W1-2L	30	30			6.25								1		X							INSTALL IN GRASS PATCH JUST WEST OF DRIVE #622	X		
WB	10.470	F	W2-2MR	30	30		MODIFIED RIGHT SIDE ROAD			1				X														
		F	W16-8A	36	8		OTTER CREEK RD PLAQUE			1																		
WB	10.384	G	VR-017	24	30		LEGAL LOAD LIMIT 24000 LBS			1				X														
WB	10.315	H	R1-1	30	30		STOP			1				X														
WB	10.262	F	W1-3R	30	30		RIGHT REVERSE TURN						1	X														
		F	W1-4R	30	30		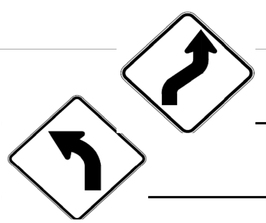	6.25																		X		
WB	9.810	F	W1-2L	30	30			6.25								1		X							INSTALL 85' +/- EAST OF DRIVE	X		
WB	9.779	F	W1-6	48	24								1		X													
		F	W1-6L	48	24		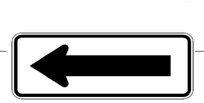	8.00								2		X								X		
WB	9.734	E	W1-6R	48	24		<=== RIGHT LARGE ARROW			1				X														
							SHEET TOTALS	~~26.75~~ 20.50 SF	0.00 SF	9 EA	0 EA	0 EA	2 EA	0 EA	0 EA	4 EA	60 FT											
							TOWN DIRECTIONAL TOTALS	296.9	0.0	34.0	6.0	6.0	50	0.0	0.0	51	765.0											

SIGN SUMMARY SHEET

VERMONT AGENCY OF TRANSPORTATION

PROJECT NAME: **Statewide - Northwest Region**
PROJECT NUMBER: **STPG SIGN(30)**

FILE NAME: **Addison WB.xls**
PROJECT MANAGER: **A. Gamble**
DESIGNED BY: **T. Guazzoni**
ADDISON VT 17 WESTBOUND SHEET 1

PLOT DATE: **8/11/2010**
DRAWN BY: **T. Guazzoni**
CHECKED BY: **A. Gamble**
SHEET **50** OF **131**