DIRECTION	MILEPOINT	LOCATION CODE (SHEET 2)	SIGN CODE	WIDTH (IN)	HEIGHT (IN)	SHEETING REMARKS	SIGN LEGEND	NEW SIGNS "A"	NEW SIGNS "B"	EXISTING SIGNS RETAIN	EXISTING SIGNS SALVAGE FROM	EXISTING SIGNS SALVAGE TO	EXISTING SIGNS REMOVE	EXIST POST RETAIN	EXIST POST REMOVE	NUMBER OF NEW POSTS	SQUARE STEEL (IN) 1.75 (LB / FT) 1.88	SQUARE STEEL (IN) 2.00 (LB / FT) 2.42	SQUARE STEEL (IN) 2.50 (LB / FT) 3.35	TUBULAR STEEL Ø (IN) FOUNDATION	TUBULAR STEEL Ø (IN) 3.00 (LB / FT) 7.60	TUBULAR STEEL Ø (IN) 3.50 (LB / FT) 9.00	TUBULAR STEEL Ø (IN) 4.00 (LB / FT) 10.80	TUBULAR STEEL Ø (IN) 5.00 (LB / FT) 14.60	SIGN FRAME REQUIRED	REMARKS	SIGN DETAIL: DETAIL IN SHS	SIGN DETAIL: DETAIL ON SHEET NUMBER	SIGN DETAIL: DETAIL ON STD SHEET NUMBER
MIDDLEBURY SOUTHBOUND							FY-FLUORESCENT YELLOW FYG-FLUORESCENT YELLOW GREEN																			"SHS"-STANDARD HIGHWAY SIGNS			
		F	M6-3	21	15								1															
		F	M3-4	24	12								1															
		F	M1-5A	30	24								1															
		F	M6-1	21	15								1															
		F	D1-1A	72	12		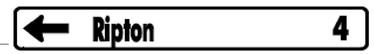	6.00																		5	
		F	D1-1A	72	12			6.00																		5	
		F	D1-1A	72	12		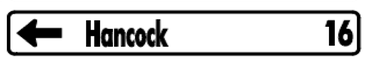	6.00																		5	
		F	D1-1A	72	12		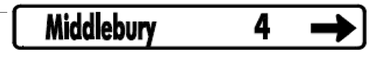	6.00																		5	
SB	0.600	F	R2-1	24	30		SPEED LIMIT 35						1		X	2												
		F	R8-3A	24	24		NO PARKING						1															
		F	M3-2	24	12			2.00																	#3C	GREEN ON WHITE SHEETING	X		
		F	M1-5A	30	24			5.00																				E-136B
		F	M6-1	21	15			~~2.25~~ 2.19																		GREEN ON WHITE SHEETING	X		
		F	M3-3	24	12			2.00																		GREEN ON WHITE SHEETING	X		
		F	M1-5A	30	24			5.00																				E-136B
SIGN SUMMARY SHEET							SHEET TOTALS	~~40.25~~ 40.19 SF	0.00 SF	0 EA	0 EA	0 EA	6 EA	0 EA	0 EA	~~0~~ 2 EA	0 FT											
VERMONT AGENCY OF TRANSPORTATION							TOWN DIRECTIONAL TOTALS	324.5	0.0	15.0	3.0	3.0	69	0.0	0.0	44	660.0											

PROJECT NAME: **Statewide - Northwest Region**
PROJECT NUMBER: **STPG SIGN(30)**

FILE NAME: **Middlebury SB.xls** PLOT DATE: **8/11/2010**
PROJECT MANAGER: **A. Gamble** DRAWN BY: **T. Guazzoni**
DESIGNED BY: **T. Guazzoni** CHECKED BY: **A. Gamble**
MIDDLEBURY VT 116 SB SHEET 7 SHEET **83** OF **131**