DIRECTION	MILEPOINT	LOCATION CODE (SHEET 2)	SIGN CODE	WIDTH (IN)	HEIGHT (IN)	SHEETING REMARKS	SIGN LEGEND	NEW SIGNS "A"	NEW SIGNS "B"	EXISTING SIGNS RETAIN	EXISTING SIGNS SALVAGE FROM	EXISTING SIGNS SALVAGE TO	EXISTING SIGNS REMOVE	EXIST POST RETAIN	EXIST POST REMOVE	NUMBER OF NEW POSTS	SQUARE STEEL (IN) 1.75 (LB / FT) 1.88	SQUARE STEEL (IN) 2.00 (LB / FT) 2.42	SQUARE STEEL (IN) 2.50 (LB / FT) 3.35	FOUNDATION	TUBULAR STEEL Ø (IN) 3.00 (LB / FT) 7.60	TUBULAR STEEL Ø (IN) 3.50 (LB / FT) 9.00	TUBULAR STEEL Ø (IN) 4.00 (LB / FT) 10.80	TUBULAR STEEL Ø (IN) 5.00 (LB / FT) 14.60	SIGN FRAME REQUIRED	REMARKS	SIGN DETAIL DETAIL IN SHS	SIGN DETAIL DETAIL ON SHEET NUMBER	SIGN DETAIL DETAIL ON STD SHEET NUMBER
BRISTOL NORTHBOUND							FY-FLUORESCENT YELLOW FYG-FLUORESCENT YELLOW GREEN																			"SHS"-STANDARD HIGHWAY SIGNS			
NB	0	C	VD-024	60	7.5								1		X													
		C	VD-024	72	10		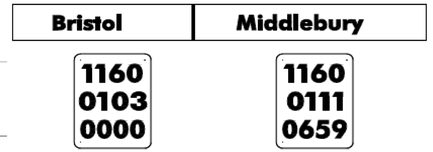	5.00								2		X									4	
		C	VD-700	6	10			~~0.42~~																				
		C	VD-700	6	10			0.42																				
NB	1.398	A	S3-1	30	30		SCHOOL BUS STOP AHEAD						1		X													
NB	1.465	A	S3-1	36	36	FYG		9.00								2		X								INSTALL 370'+/- NORTH OF EXISTING SCHOOL BUS STOP AGEAD SIGN	X		
NB	1.752	C	VR-017	24	30								1		X													
		C	VR-017	24	30			5.00								1		X								UPPER NOTCH RD (TH-8)			E-141
NB	1.759	D	R1-1	30	30								1		X													
		D	R1-1	30	30			6.25								1		X								UPPER NOTCH RD (TH-8)	X		
NB	1.76	B	D1-1G	54	7.5		DESTINATION SIGN			1				X														
		A	D1-1G	54	7.5		DESTINATION SIGN			1																		
NB	2.455	A	W1-2R	30	30		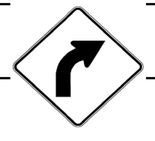	6.25								1		X								INSTALL 10' SOUTH OF POLE 464/5/67A	X		
NB	2.85	A	W1-1L	30	30		LEFT TURN			1				X														
		A	W13-1	18	18		30 MPH PLAQUE			1																		
SIGN SUMMARY SHEET							SHEET TOTALS	~~32.34~~ 31.92 SF	0.00 SF	4 EA	0 EA	0 EA	4 EA	0 EA	0 EA	7 EA		105 FT										
VERMONT AGENCY OF TRANSPORTATION							TOWN DIRECTIONAL TOTALS	348.6	0.0	46.0	1.0	1.0	69	0.0	0.0	56		840.0										

PROJECT NAME: Statewide - Northwest Region
PROJECT NUMBER: STPG SIGN(30)

FILE NAME: Bristol NB.xls
PROJECT MANAGER: A. Gamble
DESIGNED BY: T. Guazzoni
BRISTOL VT 116 NORTHBOUND SHEET 1

PLOT DATE: 8/11/2010
DRAWN BY: T. Guazzoni
CHECKED BY: A. Gamble
SHEET 88 OF 131