DIRECTION	MILEPOINT	LOCATION CODE (SHEET 2)	SIGN CODE	WIDTH (IN)	HEIGHT (IN)	SHEETING REMARKS	SIGN LEGEND	NEW SIGNS "A"	NEW SIGNS "B"	EXISTING SIGNS RETAIN	EXISTING SIGNS SALVAGE FROM	EXISTING SIGNS SALVAGE TO	EXISTING SIGNS REMOVE	EXIST POST RETAIN	EXIST POST REMOVE	NUMBER OF NEW POSTS	SQUARE STEEL (IN) 1.75 (LB / FT) 1.88	SQUARE STEEL (IN) 2.00 (LB / FT) 2.42	SQUARE STEEL (IN) 2.50 (LB / FT) 3.35	FOUNDATION	TUBULAR STEEL Ø (IN) 3.00 (LB / FT) 7.60	TUBULAR STEEL Ø (IN) 3.50 (LB / FT) 9.00	TUBULAR STEEL Ø (IN) 4.00 (LB / FT) 10.80	TUBULAR STEEL Ø (IN) 5.00 (LB / FT) 14.60	SIGN FRAME REQUIRED	REMARKS	SIGN DETAIL: DETAIL IN SHS	SIGN DETAIL: DETAIL ON SHEET NUMBER	SIGN DETAIL: DETAIL ON STD SHEET NUMBER
BRISTOL NORTHBOUND							FY-FLUORESCENT YELLOW FYG-FLUORESCENT YELLOW GREEN																			"SHS"-STANDARD HIGHWAY SIGNS			
		A	W1-2R	30	30			6.25								2		X									X		
		A	VW-081R	30	30			6.25																				7	
NB	5.33	A	W3-1	36	36								1		X														
		A	W3-1	36	36		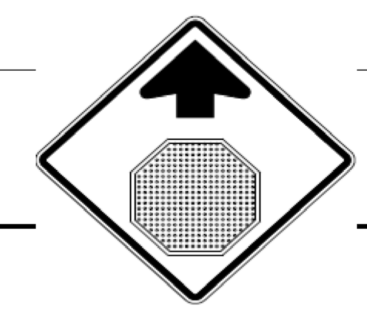	9.00								2		X									X		
NB	5.375	A	M2-1	21	15								1		X														
		A	M1-5A	24	24								1																
		A	M2-1	21	15			2.25								1		X								GREEN ON WHITE SHEETING	X		
		A	M1-5A	24	24			~~4.00~~																					E-136B
NB	5.408	A	D1-1A	72	12		DESTINATION SIGN			1				X															
		A	D1-1A	72	12		DESTINATION SIGN			1																			
		A	D1-1A	72	12		DESTINATION SIGN			1																			
		A	D1-1A	72	12		DESTINATION SIGN			1																			
NB	5.44	A	M3-4	24	12		ROUTE MARKER ASSEMBLY						1		X														
		A	M1-5A	24	24								1																
		A	M5-1	21	15								1																
SIGN SUMMARY SHEET							SHEET TOTALS	23.75 ~~27.75~~	0.00	4	0	0	6	0	0	5		75											
								SF	SF	EA	EA	EA	EA	EA	EA	EA		FT											
VERMONT AGENCY OF TRANSPORTATION							TOWN DIRECTIONAL TOTALS	348.6	0.0	46.0	1.0	1.0	69	0.0	0.0	56		840.0											

PROJECT NAME: **Statewide - Northwest Region**
PROJECT NUMBER: **STPG SIGN(30)**
FILE NAME: **Bristol NB.xls** PLOT DATE: **8/11/2010**
PROJECT MANAGER: **A. Gamble** DRAWN BY: **T. Guazzoni**
DESIGNED BY: **T. Guazzoni** CHECKED BY: **A. Gamble**
BRISTOL VT 116 NORTHBOUND SHEET 4 SHEET **91** OF **131**