DIRECTION	MILEPOINT	LOCATION CODE (SHEET 2)	SIGN CODE	WIDTH (IN)	HEIGHT (IN)	SHEETING REMARKS	SIGN LEGEND	NEW SIGNS "A"	NEW SIGNS "B"	EXISTING SIGNS RETAIN	EXISTING SIGNS SALVAGE FROM	EXISTING SIGNS SALVAGE TO	EXISTING SIGNS REMOVE	EXIST POST RETAIN	EXIST POST REMOVE	NUMBER OF NEW POSTS	SQUARE STEEL (IN) 1.75 (LB / FT) 1.88	SQUARE STEEL (IN) 2.00 (LB / FT) 2.42	SQUARE STEEL (IN) 2.50 (LB / FT) 3.35	TUBULAR STEEL Ø (IN) FOUNDATION	TUBULAR STEEL Ø (IN) 3.00 (LB / FT) 7.60	TUBULAR STEEL Ø (IN) 3.50 (LB / FT) 9.00	TUBULAR STEEL Ø (IN) 4.00 (LB / FT) 10.80	TUBULAR STEEL Ø (IN) 5.00 (LB / FT) 14.60	SIGN FRAME REQUIRED	REMARKS	SIGN DETAIL: DETAIL IN SHS	SIGN DETAIL: DETAIL ON SHEET NUMBER	SIGN DETAIL: DETAIL ON STD SHEET NUMBER
BRISTOL SOUTHBOUND							FY-FLUORESCENT YELLOW FYG-FLUORESCENT YELLOW GREEN																			"SHS"-STANDARD HIGHWAY SIGNS			
		F	M1-5	30	24								1															
		F	M3-3	24	12			2.00								1		X								GREEN ON WHITE SHEETING	X		
		F	M1-5	30	24			5.00																				E-136B
SB	5.401	F	D1-1M	72	12		DESTINATION SIGN			1				X														
		F	D2-1	72	12		DESTINATION SIGN			1																		
SB	5.363	F	R2-1	24	30			5.00								1		X								INSTALL 200' +/- SOUTH OF DESTINATION SIGN			
SB	5.340	F	W11-5	30	30		FARM MACHINERY SYMBOL				1				X												RELOCATE SIDNS TO MP 5.302			
		F	W7-3A	24	18		NEXT 2 1/2 MILES				1																	
SB	5.302	F	W11-5	30	30		FARM MACHINERY SYMBOL					1				1		X									RELOCATED SIGNS FROM MP 5.340. INSTALL 200' +/- FROM PREVIOUS LOCATION			
	5.280	F	W7-3A	24	18		HORSE NEXT 2 1/2 MILES	6.25				1				1												
SB	5.060	F	VD-062B	72	16		BUSINESS SIGN			1				X														
SB	4.676	F	VW-205	36	36		WATCH FOR TURNING VEHICLES						1		X													
SB	4.500	F	W11-5	30	30		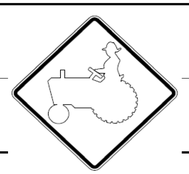						1		X													
		F	W11-5	30	30			6.25								1		X									X	
SB	4.150	F	VR-072	24	30		THINK			1	1	1		X														
SIGN SUMMARY SHEET							SHEET TOTALS	24.50 13.25	0.00	4	3 2	3 2	3	0	0	4		60									
VERMONT AGENCY OF TRANSPORTATION								SF	SF	EA	EA	EA	EA	EA	EA	EA		FT									
							TOWN DIRECTIONAL TOTALS	322.5	0.0	41.0	2.0	2.0	70	0.0	0.0	49		735.0									

PROJECT NAME: **Statewide - Northwest Region**
PROJECT NUMBER: **STPG SIGN(30)**

FILE NAME: **Bristol SB.xls** PLOT DATE: **8/11/2010**
PROJECT MANAGER: **A. Gamble** DRAWN BY: **T. Guazzoni**
DESIGNED BY: **T. Guazzoni** CHECKED BY: **A. Gamble**
BRISTOL VT 116 SOUTHBOUND SHEET 10 SHEET **110** OF **131**