DIRECTION	MILEPOINT	LOCATION CODE (SHEET 2)	SIGN CODE	WIDTH (IN)	HEIGHT (IN)	SHEETING REMARKS	SIGN LEGEND	NEW SIGNS "A"	NEW SIGNS "B"	EXISTING SIGNS RETAIN	EXISTING SIGNS SALVAGE FROM	EXISTING SIGNS SALVAGE TO	EXISTING SIGNS REMOVE	EXIST POST RETAIN	EXIST POST REMOVE	NUMBER OF NEW POSTS	SQUARE STEEL (IN) 1.75 (LB / FT) 1.88	SQUARE STEEL (IN) 2.00 (LB / FT) 2.42	SQUARE STEEL (IN) 2.50 (LB / FT) 3.35	TUBULAR STEEL Ø (IN) FOUNDATION	TUBULAR STEEL Ø (IN) 3.00 (LB / FT) 7.60	TUBULAR STEEL Ø (IN) 3.50 (LB / FT) 9.00	TUBULAR STEEL Ø (IN) 4.00 (LB / FT) 10.80	TUBULAR STEEL Ø (IN) 5.00 (LB / FT) 14.60	SIGN FRAME REQUIRED	REMARKS	SIGN DETAIL: DETAIL IN SHS	SIGN DETAIL: DETAIL ON SHEET NUMBER	SIGN DETAIL: DETAIL ON STD SHEET NUMBER
BRATTLEBORO EB							FY-FLUORESCENT YELLOW FYG-FLUORESCENT YELLOW GREEN																			"SHS"-STANDARD HIGHWAY SIGNS			
		A	R3-17	30	24			5.00								1		14.5' X								NOTE DIFFERENT DESIGN COMPARED TO EXISTING	X		
		A	R3-17a	30	12			2.50																			INSTALL PLAQUE ON BOTTOM	X		
EB	4.174	A	unknown	24	6		CARS (PLAQUE)						1		X														
		A	R2-1	24	30		SPEED LIMIT 30						1																
		A	unknown	24	12		BUS / TRUCKS (PLAQUE)						1		X														
		A	R2-1	24	30		SPEED LIMIT 25						1																
		A	VR-038	24	18		STATE HIGHWAY ENDS						1																
		A	VR-038	24	18			3.00								2		14.5' 15.0' X						# 1	INSTALL "STATE HIGHWAY ENDS" SIGN ON LEFT SIDE, ABOVE THE NEW SPEED LIMIT SIGNS		6	
		A	R2-1	24	30			5.00																			INSTALL SPEED LIMIT 30 UNDER THE STATE HIGHWAY ENDS SIGN	X		
		A	R2-2	24	24			4.00																			INSTALL TRUCK SPEED LIMIT SIGN UNDER THE SPEED LIMIT 30 SIGN	X		
		A	M4-6	24	12			2.00																			**BLACK ON WHITE**; INSTALL ON TOP TO RIGHT OF STATE HIGHWAY ENDS SIGN; USE A SIGN FRAME	X		
		A	R8-3A	24	24			4.00																			NO PARKING SYMBOL BELOW THE "END" PLAQUE	X		
EB	4.187	D	R1-1	30	30		0090 1302 04.26 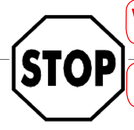 WESTERN AVE. EDWARD HEIGHTS						1		X							MILE MARKER WAS RE-INSTALLED ON THE NEW POST					EDWARD HEIGHTS RD (TH-700)			
		D	R1-1	30	30			6.25			2	2				1		12.75' X									(NO LEGAL LOAD SIGN TO BE INSTALLED HERE)	X		
EB	4.188	A	W11-2	30	30								1		X														6
							SHEET TOTALS	31.75 SF	0.00 SF	0 EA	~~2~~ 0 EA	~~2~~ 0 EA	7 EA	0 EA	0 EA	4 EA		~~60~~ 56.75 FT										
							TOWN DIRECTIONAL TOTALS	305.3	0.0	4.0	1.0	1.0	66	0.0	0.0	53		795.0										

SIGN SUMMARY SHEET

VERMONT AGENCY OF TRANSPORTATION

PROJECT NAME: **STATEWIDE SOUTHEAST REGION**
PROJECT NUMBER: **STPG SIGN (31)**

FILE NAME: **BRATTLEBORO EASTBOUND** PLOT DATE: **8/11/2010**
PROJECT MANAGER: **A. GAMBLE** DRAWN BY: **M. MILLER**
DESIGNED BY: **M. MILLER** CHECKED BY: **A. GAMBLE**
BRATTLEBORO VT-9 EASTBOUND 9 SHEET **18** OF **175**