DIRECTION	MILEPOINT	LOCATION CODE (SHEET 2)	SIGN CODE	WIDTH (IN)	HEIGHT (IN)	SHEETING REMARKS	SIGN LEGEND	NEW SIGNS "A"	NEW SIGNS "B"	EXISTING SIGNS RETAIN	EXISTING SIGNS SALVAGE FROM	EXISTING SIGNS SALVAGE TO	EXISTING SIGNS REMOVE	EXIST POST RETAIN	EXIST POST REMOVE	NUMBER OF NEW POSTS	SQUARE STEEL (IN) 1.75 (LB / FT) 1.88	SQUARE STEEL (IN) 2.00 (LB / FT) 2.42	SQUARE STEEL (IN) 2.50 (LB / FT) 3.35	FOUNDATION	TUBULAR STEEL Ø (IN) 3.00 (LB / FT) 7.60	TUBULAR STEEL Ø (IN) 3.50 (LB / FT) 9.00	TUBULAR STEEL Ø (IN) 4.00 (LB / FT) 10.80	TUBULAR STEEL Ø (IN) 5.00 (LB / FT) 14.60	SIGN FRAME REQUIRED	REMARKS	SIGN DETAIL: DETAIL IN SHS	SIGN DETAIL: DETAIL ON SHEET NUMBER	SIGN DETAIL: DETAIL ON STD SHEET NUMBER
NEWFANE NB							FY-FLUORESCENT YELLOW FYG-FLUORESCENT YELLOW GREEN																			"SHS"-STANDARD HIGHWAY SIGNS			
		A	S4-3P	24	8	FYG		1.33																		SPAN THE PLAQUE ACROSS BOTH POSTS, CENTERED UNDER THE PRIMARY SIGN	X		
NB	0.967	A	D1-2	72	20								2 ~~1~~		X													
		A	D1-2	72	20			10.00								2		12.5' 14.0' X		TWO SIGNS WERE REMOVED AT THIS LOCATION							9	
NB	1.041	C	VR-017	24	30		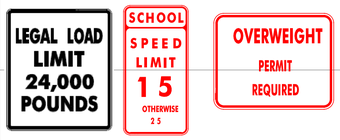						1		X												BROOK STREET (TH-84)			
		C	VR-017	24	30			5.00			2	2	2			1		16.0' X		PAY FOR REMOVAL						SIGNS SALVAGED ONTO THE NEW POST.		6	
NB	1.049	D	R1-1	30	30								1		X													
		D	R1-1	30	30			6.25								1		12.75' X									X	
NB	1.064	A	M3-1	24	12		NORTH						1		X													
		A	M1-5	24	24		VERMONT 30						1															
NB	1.100	A	R2-1	24	30								1		X													
		A	R2-1	24	30			5.00								1		13.0' X									X	
NB	1.432	A	W3-5	36	36		SPEED REDUCTION 40-MPH SYMBOL			~~1~~	1	1	1	~~X~~	X			13.0' 13.0' X		POST WERE DAMAGED , SO THEY WERE REPLACED. PAY FOR REMOVAL						~~AS-NEW, RETAIN ALL~~			
NB	1.466	C	VR-017	24	24		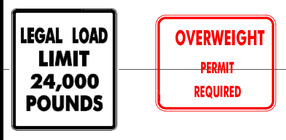						1		X												BROOK STREET (TH-84)			
		C	VR-017	24	30			5.00			1	1	1			1		14.5' X								SIGNS SALVAGED ONTO THE NEW POST.		6	
NB	1.478	D	R1-1	30	30		STOP			~~1~~	1	1	1	~~X~~	X			12.75' X		POST WAS DAMAGED, SO A NEW POST WAS INSTALLED.						AS-NEW, RETAIN ALL PAY FOR REMOVAL			
							SHEET TOTALS	32.58	0.00	0 ~~2~~	5 ~~0~~	5 ~~0~~	13 ~~7~~	0	0	6		~~90~~ 121.50											
								SF	SF	EA	EA	EA	EA	EA	EA	EA		FT											
							TOWN DIRECTIONAL TOTALS	261.0	0.0	27.0	0.0	0.0	52	0.0	0.0	47		705.0											

SIGN SUMMARY SHEET

VERMONT AGENCY OF TRANSPORTATION

PROJECT NAME: STATEWIDE SOUTHEAST REGION
PROJECT NUMBER: STPG SIGN (31)

FILE NAME: NEWFANE NORTHBOUND
PROJECT MANAGER: A. GAMBLE
DESIGNED BY: M. MILLER
NEWFANE VT-30 NORTHBOUND 2

PLOT DATE: 8/12/2010
DRAWN BY: M. MILLER
CHECKED BY: A. GAMBLE