DIRECTION	MILEPOINT	LOCATION CODE (SHEET 2)	SIGN CODE	WIDTH (IN)	HEIGHT (IN)	SHEETING REMARKS	SIGN LEGEND	NEW SIGNS "A"	NEW SIGNS "B"	EXISTING SIGNS RETAIN	EXISTING SIGNS SALVAGE FROM	EXISTING SIGNS SALVAGE TO	EXISTING SIGNS REMOVE	EXIST POST RETAIN	EXIST POST REMOVE	NUMBER OF NEW POSTS	SQUARE STEEL (IN) 1.75 (LB / FT) 1.88	SQUARE STEEL (IN) 2.00 (LB / FT) 2.42	SQUARE STEEL (IN) 2.50 (LB / FT) 3.35	FOUNDATION	TUBULAR STEEL Ø (IN) 3.00 (LB / FT) 7.60	TUBULAR STEEL Ø (IN) 3.50 (LB / FT) 9.00	TUBULAR STEEL Ø (IN) 4.00 (LB / FT) 10.80	TUBULAR STEEL Ø (IN) 5.00 (LB / FT) 14.60	SIGN FRAME REQUIRED	REMARKS	SIGN DETAIL: DETAIL IN SHS	SIGN DETAIL: DETAIL ON SHEET NUMBER	SIGN DETAIL: DETAIL ON STD SHEET NUMBER
NEWFANE NB							FY-FLUORESCENT YELLOW FYG-FLUORESCENT YELLOW GREEN																			"SHS"-STANDARD HIGHWAY SIGNS			
NB	2.045	A	VW-054	30	30			6.25								1		14.25' X										E-154
NB	2.240	C	VR-017	24	30		LEGAL LOAD LIMIT 24000 POUNDS			1				X												BACK STREET (TH-18); NEWFANE-TOWNSHEND STP 2401(1) TO REPLACE IN 2010			
NB	2.250	D	R1-1	30	30		0300 1312 0227 STOP			1				X												NEWFANE-TOWNSHEND STP 2401(1) TO REPLACE IN 2010			
NB	2.267	A	R2-1	24	30								1		X														
		A	R2-1	24	30			5.00								1		13.0' X									X	
NB	2.430	A	W3-5	36	36								1		X														
		A	W3-5	36	36			9.00								2		13.75' 14.0' X									X	
NB	2.527	A	R2-1	24	30								1		X														
		A	R2-1	30	36			7.50								1		14.0' X								NOTE THAT NEW SIGN IS SLIGHTLY LARGER		6	
NB	2.535	C	VR-017	24	30		LEGAL LOAD LIMIT 24000 POUNDS			1				X												BACK STREET (TH-18); NEWFANE-TOWNSHEND STP 2401(1) TO REPLACE IN 2010			
NB	2.545	D	R1-1	30	30		0300 1312 0258 STOP			1				X												NEWFANE-TOWNSHEND STP 2401(1) TO REPLACE IN 2010			
NB	2.551	A	VW-290	30	30								1		X														
		A	W7-3A	24	18		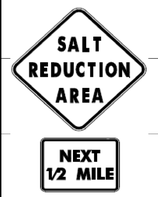						1																
		A	VW-290	30	30			6.25								1		16.5' X										5	
		A	W7-3A	24	18			3.00																			X		
							SHEET TOTALS	37.00	0.00	4	0	0	5	0	0	6		~~90~~ 85.5'											
								SF	SF	EA	EA	EA	EA	EA	EA	EA		FT											
							TOWN DIRECTIONAL TOTALS	261.0	0.0	27.0	0.0	0.0	52	0.0	0.0	47		705.0											

SIGN SUMMARY SHEET

VERMONT AGENCY OF TRANSPORTATION

PROJECT NAME: STATEWIDE SOUTHEAST REGION
PROJECT NUMBER: STPG SIGN (31)

FILE NAME: NEWFANE NORTHBOUND
PROJECT MANAGER: A. GAMBLE
DESIGNED BY: M. MILLER
NEWFANE VT-30 NORTHBOUND 4

PLOT DATE: 8/12/2010
DRAWN BY: M. MILLER
CHECKED BY: A. GAMBLE
SHEET 32 OF 175