DIRECTION	MILEPOINT	LOCATION CODE (SHEET 2)	SIGN CODE	WIDTH (IN)	HEIGHT (IN)	SHEETING REMARKS	SIGN LEGEND	NEW SIGNS "A"	NEW SIGNS "B"	EXISTING SIGNS RETAIN	EXISTING SIGNS SALVAGE FROM	EXISTING SIGNS SALVAGE TO	EXISTING SIGNS REMOVE	EXIST POST RETAIN	EXIST POST REMOVE	NUMBER OF NEW POSTS	SQUARE STEEL (IN) 1.75 (LB / FT) 1.88	SQUARE STEEL (IN) 2.00 (LB / FT) 2.42	SQUARE STEEL (IN) 2.50 (LB / FT) 3.35	FOUNDATION	TUBULAR STEEL Ø (IN) 3.00 (LB / FT) 7.60	TUBULAR STEEL Ø (IN) 3.50 (LB / FT) 9.00	TUBULAR STEEL Ø (IN) 4.00 (LB / FT) 10.80	TUBULAR STEEL Ø (IN) 5.00 (LB / FT) 14.60	SIGN FRAME REQUIRED	REMARKS	SIGN DETAIL: DETAIL IN SHS	SIGN DETAIL: DETAIL ON SHEET NUMBER	SIGN DETAIL: DETAIL ON STD SHEET NUMBER
NEWFANE NB							FY-FLUORESCENT YELLOW FYG-FLUORESCENT YELLOW GREEN																			"SHS"-STANDARD HIGHWAY SIGNS			
		A	M1-5	24	24								1															
		A	M3-1	24	12		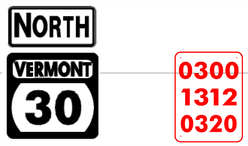	2.00								1		13.25' X								GREEN ON WHITE	X		
		A	M1-5	24	24			4.00																				E-136B
NB	3.296	A	R2-1	24	30								1		X													
		A	R2-1	24	30			5.00								1		13.75' X									X	
NB	3.333	A	W11-8	30	30		FIRE ENGINE SYMBOL						1		X											NOTE LOCATION OF REMOVAL FOR REFERENCE, FOR REPLACEMENT SIGN AHEAD			
NB	3.368	A	W11-8	30	30			6.25								1		15.0' X								INSTALL 185 FT ± NORTH OF PREVIOUS POSITION; MAINTAIN 10 FT MINIMUM TO UTILITY POLE	X		
NB	3.536	A	R2-1	24	30								1		X													
		A	R2-1	24	30			5.00								1		13.5' X									X	
NB	3.685	A	VD-062B	72	16		BUSINESS DIRECTORY SIGN			1				X												WINDMILL HILL ALPACA FARM ~~LOG CABIN AT ===>~~			
		A	VD-062AL	72	16		BUSINESS DIRECTORY SIGN			1																Z POTS ===>		
NB	3.714	A	W2-2R	30	30		RIGHT SIDE ROAD (SYMBOL)						1		X											TO BE REPLACED FURTHER AHEAD		
NB	3.753	A	VD-062B	72	16		BUSINESS DIRECTORY SIGN			1				X												KENOLIE VILLAGE ==>		
		A	VD-062AS	72	16		BUSINESS DIRECTORY SIGN			1																WEST RIVER LODGE ===>		
		A	VD-062AL	72	16		BUSINESS DIRECTORY SIGN			1																WINCHESTER STABLES ===>		
SIGN SUMMARY SHEET							SHEET TOTALS	22.25	0.00	5	0	0	5	0	0	4		~~60~~ 55.5										
								SF	SF	EA	EA	EA	EA	EA	EA	EA		FT										
VERMONT AGENCY OF TRANSPORTATION							TOWN DIRECTIONAL TOTALS	261.0	0.0	27.0	0.0	0.0	52	0.0	0.0	47		705.0										

PROJECT NAME: **STATEWIDE SOUTHEAST REGION**
PROJECT NUMBER: **STPG SIGN (31)**

FILE NAME: **NEWFANE NORTHBOUND** PLOT DATE: **8/12/2010**
PROJECT MANAGER: **A. GAMBLE** DRAWN BY: **M. MILLER**
DESIGNED BY: **M. MILLER** CHECKED BY: **A. GAMBLE**
NEWFANE VT-30 NORTHBOUND 6 SHEET **34** OF **175**