DIRECTION	MILEPOINT	LOCATION CODE (SHEET 2)	SIGN CODE	WIDTH (IN)	HEIGHT (IN)	SHEETING REMARKS	SIGN LEGEND	NEW SIGNS "A"	NEW SIGNS "B"	EXISTING SIGNS RETAIN	EXISTING SIGNS SALVAGE FROM	EXISTING SIGNS SALVAGE TO	EXISTING SIGNS REMOVE	EXIST POST RETAIN	EXIST POST REMOVE	NUMBER OF NEW POSTS	SQUARE STEEL (IN) 1.75 (LB / FT) 1.88	SQUARE STEEL (IN) 2.00 (LB / FT) 2.42	SQUARE STEEL (IN) 2.50 (LB / FT) 3.35	TUBULAR STEEL Ø (IN) FOUNDATION	TUBULAR STEEL Ø (IN) 3.00 (LB / FT) 7.60	TUBULAR STEEL Ø (IN) 3.50 (LB / FT) 9.00	TUBULAR STEEL Ø (IN) 4.00 (LB / FT) 10.80	TUBULAR STEEL Ø (IN) 5.00 (LB / FT) 14.60	SIGN FRAME REQUIRED	REMARKS	SIGN DETAIL: DETAIL IN SHS	SIGN DETAIL: DETAIL ON SHEET NUMBER	SIGN DETAIL: DETAIL ON STD SHEET NUMBER
TOWNSHEND NB							FY-FLUORESCENT YELLOW FYG-FLUORESCENT YELLOW GREEN																			"SHS"-STANDARD HIGHWAY SIGNS			
NB	1.953	A	M6-2	21	15				1																			
		A	D1-1A	72	12		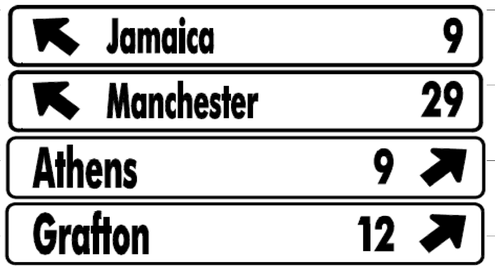	6.00								2		15.75' 15.75' X								4
		A	D1-1A	72	12			6.00																				4
		A	D1-1A	72	12			6.00																				4
		A	D1-1A	72	12			6.00																				4
		A	D9-2	24	24			4.00																			INSTALL HOSPITAL SIGNS ON RIGHT-SIDE POST	X	
		A	M6-2	21	15			2.19																			**WHITE ON BLUE**	X	
NB	1.975	A	W1-10L	30	30								1		X														
		A	W1-10L	30	30			6.25								1		13.0' X										X	
NB	1.995	A	W11-2	30	30	FYG	PEDESTRIAN SYMBOL			1				X													NEWFANE-TOWNSHEND STP 2401(1) TO REPLACE IN 2010			
		A	W16-7	24	12	FYG	DIAGONAL ARROW (45 DEG DOWN)			1																				
NB	2.015	A	M3-1	24	12								1		X														
		A	M1-5	24	24								1																
		A	M6-2	21	15		(6) SIGN ROUTE MARKER ASSEMBLY						1																	
		A	M3-1	24	12								1																
							SHEET TOTALS	36.44	0.00	2	0	0	6	0	0	3		44.5 ~~45~~										
								SF	SF	EA	EA	EA	EA	EA	EA	EA		FT										
							TOWN DIRECTIONAL TOTALS	334.0	0.0	25.0	0.0	0.0	81	0.0	0.0	54		810.0										

SIGN SUMMARY SHEET

VERMONT AGENCY OF TRANSPORTATION

PROJECT NAME: **STATEWIDE SOUTHEAST REGION**
PROJECT NUMBER: **STPG SIGN (31)**

FILE NAME: **TOWNSHEND NORTHBOUND** PLOT DATE: **8/12/2010**
PROJECT MANAGER: **A. GAMBLE** DRAWN BY: **M. MILLER**
DESIGNED BY: **M. MILLER** CHECKED BY: **A. GAMBLE**
TOWNSHEND VT-30 NORTHBOUND 5 SHEET **52** OF **175**