DIRECTION	MILEPOINT	LOCATION CODE (SHEET 2)	SIGN CODE	WIDTH (IN)	HEIGHT (IN)	SHEETING REMARKS	SIGN LEGEND	NEW SIGNS "A"	NEW SIGNS "B"	EXISTING SIGNS RETAIN	EXISTING SIGNS SALVAGE FROM	EXISTING SIGNS SALVAGE TO	EXISTING SIGNS REMOVE	EXIST POST RETAIN	EXIST POST REMOVE	NUMBER OF NEW POSTS	SQUARE STEEL (IN) 1.75 (LB / FT) 1.88	SQUARE STEEL (IN) 2.00 (LB / FT) 2.42	SQUARE STEEL (IN) 2.50 (LB / FT) 3.35	FOUNDATION	TUBULAR STEEL Ø (IN) 3.00 (LB / FT) 7.60	TUBULAR STEEL Ø (IN) 3.50 (LB / FT) 9.00	TUBULAR STEEL Ø (IN) 4.00 (LB / FT) 10.80	TUBULAR STEEL Ø (IN) 5.00 (LB / FT) 14.60	SIGN FRAME REQUIRED	REMARKS	SIGN DETAIL: DETAIL IN SHS	SIGN DETAIL: DETAIL ON SHEET NUMBER	SIGN DETAIL: DETAIL ON STD SHEET NUMBER
TOWNSHEND SB							FY-FLUORESCENT YELLOW FYG-FLUORESCENT YELLOW GREEN																			"SHS"-STANDARD HIGHWAY SIGNS			
SB	6.709	F	R2-1	24	30			5.00								1		13.0' X								X		
SB	6.663	F	R2-1	24	30								1		X													
		F	W2-2L	30	30			6.25								1		13.5' X								X		
SB	6.636	F	D1-1A	72	10								1		X													
		F	D1-1A	72	12			6.00								2		11.75' 11.75' X									4	
SB	6.577	F	W2-1M	30	30		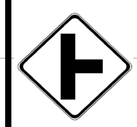 MODIFIED CROSSROAD SYMBOL						1		X													
		F	W2-2	30	30			6.25								1		13.5' X								X		
SB	6.530	F	M3-3	24	12		SOUTH						1		X													
		F	M1-5	24	24		VT 30						1															
		F	M3-3	24	12			2.00								1		13.0' X							GREEN ON WHITE	X		
		F	M1-5	24	24			4.00																				E-136B
SB	6.521	G	VR-017	24	30		LEGAL LOAD LIMIT 24000 POUNDS			1				X												ISLAND RD (TH-49); NEWFANE-TOWNSHEND STP 2401(1) TO REPLACE IN 2010			
SB	6.503	H	R1-1	30	30		0300 1317 0648 STOP			1				X												NEWFANE-TOWNSHEND STP 2401(1) TO REPLACE IN 2010			
SB	6.451	F	R2-1	24	30								1		X													
		F	R2-1	24	30			5.00								1		12.75' X								X		
							SHEET TOTALS	34.50	0.00	2	0	0	6	0	0	7		89.25 ~~105~~										
								SF	SF	EA	EA	EA	EA	EA	EA	EA		FT										
							TOWN DIRECTIONAL TOTALS	304.7	0.0	25.0	2.0	2.0	68	0.0	0.0	55		825.0										

SIGN SUMMARY SHEET

VERMONT AGENCY OF TRANSPORTATION

PROJECT NAME: STATEWIDE SOUTHEAST REGION
PROJECT NUMBER: STPG SIGN (31)

FILE NAME: TOWNSHEND SOUTHBOUND
PROJECT MANAGER: A. GAMBLE
DESIGNED BY: M. MILLER
TOWNSHEND VT-30 SOUTHBOUND 2

PLOT DATE: 8/12/2010
DRAWN BY: M. MILLER
CHECKED BY: A. GAMBLE
SHEET 62 OF 175