DIRECTION	MILEPOINT	LOCATION CODE (SHEET 2)	SIGN CODE	WIDTH (IN)	HEIGHT (IN)	SHEETING REMARKS	SIGN LEGEND	NEW SIGNS "A"	NEW SIGNS "B"	EXISTING SIGNS RETAIN	EXISTING SIGNS SALVAGE FROM	EXISTING SIGNS SALVAGE TO	EXISTING SIGNS REMOVE	EXIST POST RETAIN	EXIST POST REMOVE	NUMBER OF NEW POSTS	SQUARE STEEL (IN) (LB / FT) 1.75 / 1.88	2.00 / 2.42	2.50 / 3.35	FOUNDATION	TUBULAR STEEL Ø (IN) (LB / FT) 3.00 / 7.60	3.50 / 9.00	4.00 / 10.80	5.00 / 14.60	SIGN FRAME REQUIRED	REMARKS	SIGN DETAIL: DETAIL IN SHS	DETAIL ON SHEET NUMBER	DETAIL ON STD SHEET NUMBER
ROCKINGHAM NB							FY-FLUORESCENT YELLOW FYG-FLUORESCENT YELLOW GREEN																			"SHS"-STANDARD HIGHWAY SIGNS			
		A	M5-1	21	15		ADVANCE RIGHT ---> (90 DEG)						1																
NB	3.905	A	M3-1	24	12		NORTH			~~1~~	1	1	1		X	1		16.0' X								THE POST WAS DAMAGED, SO IT WAS REPLACED. THE SIGNS WERE SALVAGED ONTO THE NEW POST. PAY FOR REMOVALS.			
		A	M1-4	24	24		US 5			~~1~~	1	1	1																
		A	M6-1	21	15		RIGHT --->			~~1~~	1	1	1																
NB	3.933	J	R4-7	24	30								1		X											ASSEMBLY AT BEGIN OF MEDIAN ON LEFT			
		J	OM1-1	18	18								1																
		K	R1-1	30	30								1													ON BACK SIDE OF RIGHT BULLNOSE			
		K	OM1-1	18	18								1													ON BACK, UNDER THE STOP SIGN			
		J	R4-7	24	30		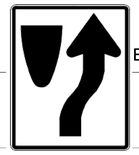 BACK-TO-BACK	5.00								1		13.0' X									X		
		J	OM1-1	18	18			2.25																			X		
		K	R1-1	30	30			6.25																			ON BACK SIDE OF RIGHT BULLNOSE	X		
		K	OM1-1	18	18			2.25																		ON BACK, UNDER THE STOP SIGN	X		
NB	3.944	A	M3-1	24	12			2.00								1		17.0' X								INSTALL 85 FT ± IN ADVANCE OF EXISTING ASSEMBLY; **BLACK ON WHITE**	X		
		A	M1-4	24	24			4.00																			X		
		A	D6-4A	18	9		AMERICA'S BYWAYS					1														SALVAGE TO BELOW THE NEW ROUTE MARKER SIGNS			
							SHEET TOTALS	21.75	0.00	3	~~0~~ 3	~~1~~ 4	~~5~~ 8	0	0	2		~~30~~ 46.0											
								SF	SF	EA	EA	EA	EA	EA	EA	EA		FT											
							TOWN DIRECTIONAL TOTALS	506.0	0.0	9.0	6.0	7.0	93	0.0	0.0	76		1140.0											

SIGN SUMMARY SHEET

VERMONT AGENCY OF TRANSPORTATION

PROJECT NAME: **STATEWIDE SOUTHEAST REGION**
PROJECT NUMBER: **STPG SIGN (31)**

FILE NAME: **ROCKINGHAM NORTHBOUND**
PROJECT MANAGER: **A. GAMBLE**
DESIGNED BY: **M. MILLER**
ROCKINGHAM US-5 NORTHBOUND 11

PLOT DATE: **8/13/2010**
DRAWN BY: **M. MILLER**
CHECKED BY: **A. GAMBLE**