DIRECTION	MILEPOINT	LOCATION CODE (SHEET 2)	SIGN CODE	WIDTH (IN)	HEIGHT (IN)	SHEETING REMARKS	SIGN LEGEND	NEW SIGNS "A"	NEW SIGNS "B"	EXISTING SIGNS RETAIN	EXISTING SIGNS SALVAGE FROM	EXISTING SIGNS SALVAGE TO	EXISTING SIGNS REMOVE	EXIST POST RETAIN	EXIST POST REMOVE	NUMBER OF NEW POSTS	SQUARE STEEL (IN) 1.75 (LB / FT) 1.88	SQUARE STEEL (IN) 2.00 (LB / FT) 2.42	SQUARE STEEL (IN) 2.50 (LB / FT) 3.35	FOUNDATION	TUBULAR STEEL Ø (IN) 3.00 (LB / FT) 7.60	TUBULAR STEEL Ø (IN) 3.50 (LB / FT) 9.00	TUBULAR STEEL Ø (IN) 4.00 (LB / FT) 10.80	TUBULAR STEEL Ø (IN) 5.00 (LB / FT) 14.60	SIGN FRAME REQUIRED	REMARKS	SIGN DETAIL: DETAIL IN SHS	SIGN DETAIL: DETAIL ON SHEET NUMBER	SIGN DETAIL: DETAIL ON STD SHEET NUMBER
ROCKINGHAM SB							FY-FLUORESCENT YELLOW FYG-FLUORESCENT YELLOW GREEN																			"SHS"-STANDARD HIGHWAY SIGNS			
		F	M1-5	30	24		JCT VERMONT 103	5.00																				E-136B
SB	4.026	F	W1-1R	30	30								1		X													
		F	W1-1R	36	36	FY		9.00								2		9.5' 11.5' X								FLUORESCENT YELLOW BACKRGROUND SHEETING	X		
SB	3.998	F	W3-1	30	30		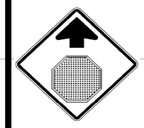 0050 1314 0400						1		X													
		F	W3-1	36	36	FY		9.00								2		13.5' 13.75' X								FLUORESCENT YELLOW BACKRGROUND SHEETING	X		
SB	3.975	F	D1-1A	72	10								1		X													
		F	D1-1A	72	10								1															
		F	D1-1A	72	12		Bellows Falls 3	6.00								2		10.25' 12.25' X										4	
		F	D1-1A	72	12		Rockingham 3	6.00																				4	
SB	3.937	F	M3-3	24	12		SOUTH						1		X													
		F	M1-4	24	24		US 5						1															
		F	M6-1	21	15		LEFT						1															
		F	M3-1	24	12		NORTH						1															
		F	M1-6	24	24		103						1															
		F	M6-1	21	15		RIGHT						1															
							SHEET TOTALS	35.00	0.00	0	0	0	10	0	0	6		70.75 ~~90~~										
								SF	SF	EA	EA	EA	EA	EA	EA	EA		FT										
							TOWN DIRECTIONAL TOTALS	442.6	0.0	9.0	3.0	3.0	78	0.0	0.0	73		1095.0										

SIGN SUMMARY SHEET

VERMONT AGENCY OF TRANSPORTATION

PROJECT NAME: STATEWIDE SOUTHEAST REGION
PROJECT NUMBER: STPG SIGN (31)

FILE NAME: ROCKINGHAM SOUTHBOUND
PROJECT MANAGER: A. GAMBLE
DESIGNED BY: M. MILLER
ROCKINGHAM US-5 SOUTHBOUND 5

PLOT DATE: 8/13/2010
DRAWN BY: M. MILLER
CHECKED BY: A. GAMBLE