| DIRECTION | MILEPOINT | LOCATION CODE (SHEET 2) | SIGN CODE | WIDTH (IN) | HEIGHT (IN) | SHEETING REMARKS | SIGN LEGEND | NEW SIGNS "A" | NEW SIGNS "B" | EXISTING SIGNS RETAIN | EXISTING SIGNS SALVAGE FROM | EXISTING SIGNS SALVAGE TO | EXISTING SIGNS REMOVE | EXIST POST RETAIN | EXIST POST REMOVE | NUMBER OF NEW POSTS | SQUARE STEEL (IN) 1.75 (LB / FT) 1.88 | SQUARE STEEL (IN) 2.00 (LB / FT) 2.42 | SQUARE STEEL (IN) 2.50 (LB / FT) 3.35 | FOUNDATION | TUBULAR STEEL Ø (IN) 3.00 (LB / FT) 7.60 | TUBULAR STEEL Ø (IN) 3.50 (LB / FT) 9.00 | TUBULAR STEEL Ø (IN) 4.00 (LB / FT) 10.80 | TUBULAR STEEL Ø (IN) 5.00 (LB / FT) 14.60 | SIGN FRAME REQUIRED | REMARKS | SIGN DETAIL DETAIL IN SHS | SIGN DETAIL DETAIL ON SHEET NUMBER | SIGN DETAIL DETAIL ON STD SHEET NUMBER |
|---|---|---|---|---|---|---|---|---|---|---|---|---|---|---|---|---|---|---|---|---|---|---|---|---|---|---|---|---|
| **CHESTER WB** | | | | | | | FY-FLUORESCENT YELLOW<br>FYG-FLUORESCENT YELLOW GREEN | | | | | | | | | | | | | | | | | | | "SHS"-STANDARD HIGHWAY SIGNS | | | |
| WB | 0.057 | F | D1-1A | 72 | 10 | | | | | | | | 1 | | | | | | | | | | | | | | | |
| | | F | D1-1A | 72 | 10 | | | | | | | | 1 | | | | | | | | | | | | | | | |
| | | F | D1-1A | 72 | 10 | | | | | | | | 1 | | | | | | | | | | | | | | | |
| | | F | D1-1A | 72 | 12 | | 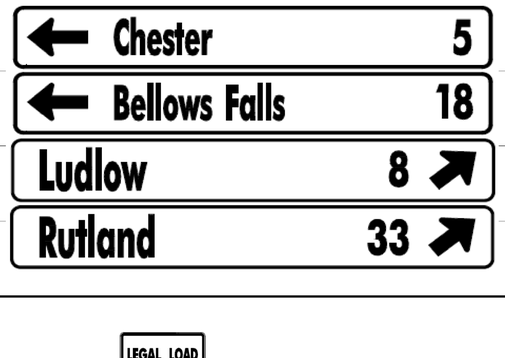 | 6.00 | | | | | | | | 2 | | 14.25'<br>15.75'<br>X | | | | | | | | 4 | |
| | | F | D1-1A | 72 | 12 | | | 6.00 | | | | | | | | | | | | | | | | | | | 4 | |
| | | F | D1-1A | 72 | 12 | | | 6.00 | | | | | | | | | | | | | | | | | | | 4 | |
| | | F | D1-1A | 72 | 12 | | | 6.00 | | | | | | | | | | | | | | | | | | | 4 | |
| WB | 0.037 | G | VR-017 | 24 | 30 | | | | | | | | 1 | | X | | | | | | | | | | | CLEMONS ROAD (TH-21) | | | |
| | | G | VR-017 | 24 | 30 | | | 5.00 | | | | | | | | 1 | | 13.0'<br>X | | | | | | | | | 6 | |
| WB | 0.031 | H | R1-1 | 30 | 30 | | 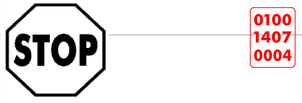 | | | | | | 1 | | X | | | | | | | | | | | | | | |
| | | H | R1-1 | 30 | 30 | | | 6.25 | | | | | | | | 1 | | 12.75'<br>X | | | | | | | | X | | |
| WB | 0.025 | F | M3-3 | 24 | 12 | | | | | | | | 1 | | X | | | | | | | | | | | | | |
| | | F | M1-5 | 30 | 24 | | | | | | | | 1 | | | | | | | | | | | | | | | |
| | | F | M6-1 | 21 | 15 | | (6) SIGN ROUTE MARKER ASSEMBLY | | | | | | 1 | | | | | | | | | | | | | | | |
| | | F | M3-1 | 24 | 12 | | | | | | | | 1 | | | | | | | | | | | | | | | |
| | | | | | | | SHEET TOTALS | 35.25 | 0.00 | 0 | 0 | 0 | 9 | 0 | 0 | 4 | | 55.75<br>~~60~~ | | | | | | | | | | |
| | | | | | | | | SF | SF | EA | EA | EA | EA | EA | EA | EA | | FT | | | | | | | | | | |
| | | | | | | | TOWN DIRECTIONAL TOTALS | 275.0 | 0.0 | 0.0 | 0.0 | 0.0 | 53 | 0.0 | 0.0 | 48 | | 720.0 | | | | | | | | | | |

# SIGN SUMMARY SHEET

VERMONT AGENCY OF TRANSPORTATION

PROJECT NAME: STATEWIDE SOUTHEAST REGION
PROJECT NUMBER: STPG SIGN (31)

FILE NAME: CHESTER WESTBOUND
PROJECT MANAGER: A. GAMBLE
DESIGNED BY: M. MILLER
CHESTER VT-10 WESTBOUND 6

PLOT DATE: 8/13/2010
DRAWN BY: M. MILLER
CHECKED BY: A. GAMBLE
SHEET 111 OF 175