DIRECTION	MILEPOINT	LOCATION CODE (SHEET 2)	SIGN CODE	WIDTH (IN)	HEIGHT (IN)	SHEETING REMARKS	SIGN LEGEND	NEW SIGNS "A"	NEW SIGNS "B"	EXISTING SIGNS RETAIN	EXISTING SIGNS SALVAGE FROM	EXISTING SIGNS SALVAGE TO	EXISTING SIGNS REMOVE	EXIST POST RETAIN	EXIST POST REMOVE	NUMBER OF NEW POSTS	SQUARE STEEL (IN) 1.75 (LB / FT) 1.88	SQUARE STEEL (IN) 2.00 (LB / FT) 2.42	SQUARE STEEL (IN) 2.50 (LB / FT) 3.35	TUBULAR STEEL Ø (IN) FOUNDATION	TUBULAR STEEL Ø (IN) 3.00 (LB / FT) 7.60	TUBULAR STEEL Ø (IN) 3.50 (LB / FT) 9.00	TUBULAR STEEL Ø (IN) 4.00 (LB / FT) 10.80	TUBULAR STEEL Ø (IN) 5.00 (LB / FT) 14.60	SIGN FRAME REQUIRED	REMARKS	SIGN DETAIL: DETAIL IN SHS	SIGN DETAIL: DETAIL ON SHEET NUMBER	SIGN DETAIL: DETAIL ON STD SHEET NUMBER
CHESTER WB							FY-FLUORESCENT YELLOW FYG-FLUORESCENT YELLOW GREEN																			"SHS"-STANDARD HIGHWAY SIGNS			
WB	0.025	F	M1-5	30	24								1																
		F	M6-2R	21	15								1																
		F	M3-3	24	12		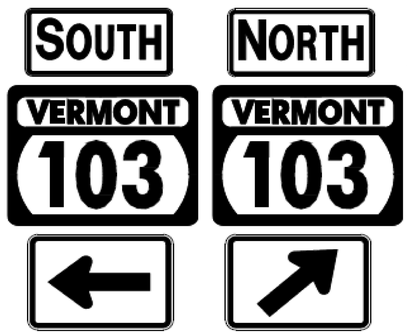	2.00								2		14.5' 15.0' X						#1B	GREEN ON WHITE	X		
		F	M1-5	30	24			5.00																					E-136B
		F	M6-1	21	15			2.19																			GREEN ON WHITE	X		
		F	M3-1	24	12			2.00																			GREEN ON WHITE	X		
		F	M1-5	30	24			5.00																					E-136B
		F	M6-2R	21	15			2.19																			GREEN ON WHITE	X		
WB	0.010	F	OM1-1	18	18								1		X														
		F	OM1-1	18	18			2.25								1	9.0' X										INSTALLED IN THE GORE BETWEEN THE TWO APPROACHES TO VT-103	X		
~~WB~~ ~~EB~~	0.002	D	R1-1	36	36								1		X														
		D	R1-1	36	36		1030 1407 0778 STOP 0100 1407 0000	9.00								2		13.25' 13.25' X										X		
~~WB~~ ~~EB~~	0.002	D	R1-2	30	30								1		X															
		D	R1-2	36	36			3.89								1		12.5' X									ON THE SLIP-LANE APPROACH TO NB VT 103	X		
WB	3.425	F	R2-1	24	30		NEW SPEED LIMIT 50 WEST REMOVE 10 REMOVE	5.00					2														THIS NEW SIGN WAS INSTALLED FOR WB MOTORISTS. SEE SHEET #106	RETAIN POST		
							SHEET TOTALS	~~38.52~~ 33.52 SF	0.00 SF	0 EA	0 EA	0 EA	~~7~~ 5 EA	0 EA	0 EA	6 EA			~~77.5~~ 90 FT							
							TOWN DIRECTIONAL TOTALS	275.0	0.0	0.0	0.0	0.0	53	0.0	0.0	48			720.0											

SIGN SUMMARY SHEET

VERMONT AGENCY OF TRANSPORTATION

PROJECT NAME: **STATEWIDE SOUTHEAST REGION**
PROJECT NUMBER: **STPG SIGN (31)**

FILE NAME: **CHESTER WESTBOUND** PLOT DATE: **8/13/2010**
PROJECT MANAGER: **A. GAMBLE** DRAWN BY: **M. MILLER**
DESIGNED BY: **M. MILLER** CHECKED BY: **A. GAMBLE**
CHESTER VT-10 WESTBOUND 7 SHEET **112** OF **175**