DIRECTION	MILEPOINT	LOCATION CODE (SHEET 2)	SIGN CODE	WIDTH (IN)	HEIGHT (IN)	SHEETING REMARKS	SIGN LEGEND	NEW SIGNS "A"	NEW SIGNS "B"	EXISTING SIGNS RETAIN	EXISTING SIGNS SALVAGE FROM	EXISTING SIGNS SALVAGE TO	EXISTING SIGNS REMOVE	EXIST POST RETAIN	EXIST POST REMOVE	NUMBER OF NEW POSTS	SQUARE STEEL (IN) 1.75 (LB / FT) 1.88	SQUARE STEEL (IN) 2.00 (LB / FT) 2.42	SQUARE STEEL (IN) 2.50 (LB / FT) 3.35	FOUNDATION	TUBULAR STEEL Ø (IN) 3.00 (LB / FT) 7.60	TUBULAR STEEL Ø (IN) 3.50 (LB / FT) 9.00	TUBULAR STEEL Ø (IN) 4.00 (LB / FT) 10.80	TUBULAR STEEL Ø (IN) 5.00 (LB / FT) 14.60	SIGN FRAME REQUIRED	REMARKS	SIGN DETAIL: DETAIL IN SHS	SIGN DETAIL: DETAIL ON SHEET NUMBER	SIGN DETAIL: DETAIL ON STD SHEET NUMBER
SPRINGFIELD EB							FY-FLUORESCENT YELLOW FYG-FLUORESCENT YELLOW GREEN																			"SHS"-STANDARD HIGHWAY SIGNS			
		A	M2-1	21	15			2.19																		GREEN ON WHITE	X		
		A	M1-5	30	24			5.00																				E-136B
EB	0.750	C	VR-017	24	30		LEGAL LOAD LIMIT 24,000 POUNDS	5.00								1		13.0' X								CEMETERY ROAD (TH-722)		6	
EB	0.765	D	R1-1	24	24		STOP (BACK-TO-BACK WITH)						1		X														
		C	VR-017	24	24		LEGAL LOAD LIMIT 24000 POUNDS						1																
		D	R1-1	30	30			6.25								1		13.0' X									X		
EB	0.770	A	M3-1	24	12		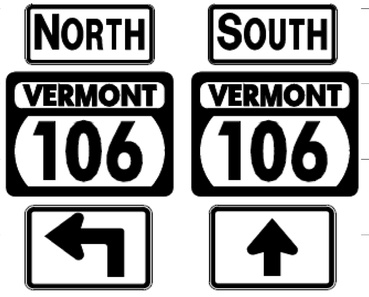	2.00								2		15.0' 14.5' X							#2B	GREEN ON WHITE	X		
		A	M1-5	30	24			5.00																		INSTALL ASSEMBLY 50 FT ± EAST OF JCT WITH CEMETERY ROAD (TH-722)			E-136B
		A	M5-1L	21	15			2.19																		GREEN ON WHITE	X		
		A	M3-3	24	12			2.00																		GREEN ON WHITE	X		
		A	M1-5	30	24			5.00																				E-136B
		A	M6-3	21	15			2.19																		GREEN ON WHITE	X		
EB	0.790	A	D1-1A	72	10		^UP SPRINGFIELD 4						1		X														
		A	D1-1A	72	10		<--- PERKINSVILLE 3						1																
		A	D1-1A	72	10		<--- WOODSTOCK 23						1																
							SHEET TOTALS	36.82	0.00	0	0	0	5	0	0	4		~~55.5~~ ~~60~~											
								SF	SF	EA	EA	EA	EA	EA	EA	EA		FT											
							TOWN DIRECTIONAL TOTALS	146.7	0.0	7.0	0.0	0.0	35	0.0	0.0	22		330.0											

SIGN SUMMARY SHEET

VERMONT AGENCY OF TRANSPORTATION

PROJECT NAME: STATEWIDE SOUTHEAST REGION
PROJECT NUMBER: STPG SIGN (31)

FILE NAME: SPRINGFIELD EASTBOUND
PROJECT MANAGER: A. GAMBLE
DESIGNED BY: M. MILLER
SPRINGFIELD VT-10 EASTBOUND 4

PLOT DATE: 8/13/2010
DRAWN BY: M. MILLER
CHECKED BY: A. GAMBLE
SHEET 116 OF 175