DIRECTION	MILEPOINT	LOCATION CODE (SHEET 2)	SIGN CODE	WIDTH (IN)	HEIGHT (IN)	SHEETING REMARKS	SIGN LEGEND	NEW SIGNS "A"	NEW SIGNS "B"	EXISTING SIGNS RETAIN	EXISTING SIGNS SALVAGE FROM	EXISTING SIGNS SALVAGE TO	EXISTING SIGNS REMOVE	EXIST POST RETAIN	EXIST POST REMOVE	NUMBER OF NEW POSTS	SQUARE STEEL (IN) 1.75 (LB / FT) 1.88	SQUARE STEEL (IN) 2.00 (LB / FT) 2.42	SQUARE STEEL (IN) 2.50 (LB / FT) 3.35	TUBULAR STEEL Ø (IN) FOUNDATION	TUBULAR STEEL Ø (IN) 3.00 (LB / FT) 7.60	TUBULAR STEEL Ø (IN) 3.50 (LB / FT) 9.00	TUBULAR STEEL Ø (IN) 4.00 (LB / FT) 10.80	TUBULAR STEEL Ø (IN) 5.00 (LB / FT) 14.60	SIGN FRAME REQUIRED	REMARKS	SIGN DETAIL: DETAIL IN SHS	SIGN DETAIL: DETAIL ON SHEET NUMBER	SIGN DETAIL: DETAIL ON STD SHEET NUMBER
WEATHERSFIELD EB							FY-FLUORESCENT YELLOW FYG-FLUORESCENT YELLOW GREEN																			"SHS"-STANDARD HIGHWAY SIGNS			
EB	1.148	A	M2-1	21	15								1		X														
		A	M1-5	30	24								1																
		A	M2-1	21	15			2.19								1		15.0' X								GREEN ON WHITE	X		
		A	M1-5	30	24			5.00																					E-136B
EB	1.192	A	W3-1	36	36								1		X														
		A	W16-2	24	18		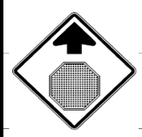						1																
		A	W3-1	36	36			9.00								2		14.5' 14.5' X								INSTALL NEW SIGN ON 2 POSTS	X		
		A	W16-2	24	18		1310 1420 0120 2 EA. BACK TO BACK	3.00													MM'S SALVAGED ONTO0 THE NEW POST					INSTALL PLAQUE ON LEFT POST	X		
EB	1.231	A	D1-1A	72	10								1	X													RETAIN THE EXISTING TUBULAR STEEL POSTS			
		A	D1-1A	72	10								1																
		A	D1-1A	72	10		(6) DESTINATION SIGNS						1																
		A	D1-1A	72	10								1																
		A	D1-1A	72	10								1																
		A	D1-1A	72	10																						SPRINGFIELD SIGN IS MISSING			
		A	D1-1A	72	12		(SEE NEXT PAGE)	6.00								~~2~~		~~X~~								INSTALL IN THE SAME VERTICAL ORDER AS SHOWN		4	
							SHEET TOTALS	25.19	0.00	0	0	0	9	0	0	5		44.0 ~~75~~											
								SF	SF	EA	EA	EA	EA	EA	EA	EA		FT											
							TOWN DIRECTIONAL TOTALS	778.3	0.0	47.0	9.0	9.0	180	0.0	0.0	108		1620.0											

SIGN SUMMARY SHEET

VERMONT AGENCY OF TRANSPORTATION

PROJECT NAME: **STATEWIDE SOUTHEAST REGION**
PROJECT NUMBER: **STPG SIGN (31)**

FILE NAME: **WEATHERSFIELD EASTBOUND** PLOT DATE: **8/19/2010**
PROJECT MANAGER: **A. GAMBLE** DRAWN BY: **M. MILLER**
DESIGNED BY: **M. MILLER** CHECKED BY: **A. GAMBLE**
WEATHERSFIELD VT-131 EB 2 SHEET **123** OF **175**