DIRECTION	MILEPOINT	LOCATION CODE (SHEET 2)	SIGN CODE	WIDTH (IN)	HEIGHT (IN)	SHEETING REMARKS	SIGN LEGEND	NEW SIGNS "A"	NEW SIGNS "B"	EXISTING SIGNS RETAIN	EXISTING SIGNS SALVAGE FROM	EXISTING SIGNS SALVAGE TO	EXISTING SIGNS REMOVE	EXIST POST RETAIN	EXIST POST REMOVE	NUMBER OF NEW POSTS	SQUARE STEEL (IN) 1.75 (LB / FT) 1.88	SQUARE STEEL (IN) 2.00 (LB / FT) 2.42	SQUARE STEEL (IN) 2.50 (LB / FT) 3.35	FOUNDATION	TUBULAR STEEL Ø (IN) 3.00 (LB / FT) 7.60	TUBULAR STEEL Ø (IN) 3.50 (LB / FT) 9.00	TUBULAR STEEL Ø (IN) 4.00 (LB / FT) 10.80	TUBULAR STEEL Ø (IN) 5.00 (LB / FT) 14.60	SIGN FRAME REQUIRED	REMARKS	SIGN DETAIL: DETAIL IN SHS	SIGN DETAIL: DETAIL ON SHEET NUMBER	SIGN DETAIL: DETAIL ON STD SHEET NUMBER
WEATHERSFIELD EB							FY-FLUORESCENT YELLOW FYG-FLUORESCENT YELLOW GREEN																			"SHS"-STANDARD HIGHWAY SIGNS			
		A	M1-5	24	24								1																
		A	M6-3	21	15								1																
		A	M3-3	24	12								1																
		A	M1-5	24	24								1																
		A	M6-1	21	15								1																
		A	M3-1	24	12		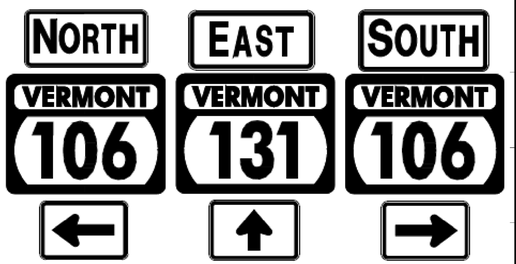	2.00						X		~~2~~		~~X~~ SEE NOTE ON PREVIOUS SHEET							# 30	GREEN ON WHITE	X		
		A	M1-5	30	24			5.00																					E-136B
		A	M6-1	21	15			2.19																		GREEN ON WHITE	X		
		A	M3-2	24	12			2.00																		GREEN ON WHITE	X		
		A	M1-5	30	24			5.00																					E-136B
		A	M6-3	21	15			2.19																		GREEN ON WHITE	X		
		A	M3-3	24	12			2.00																		GREEN ON WHITE	X		
		A	M1-5	30	24			5.00																					E-136B
		A	M6-1	21	15			2.19																		GREEN ON WHITE	X		
EB	1.302	A	R1-1	48	48								1		X														
							SHEET TOTALS	27.57	0.00	0	0	0	6	0	0	~~2~~ 0	~~30~~ 0.0												
								SF	SF	EA	EA	EA	EA	EA	EA	EA	FT												
							TOWN DIRECTIONAL TOTALS	778.3	0.0	47.0	9.0	9.0	180	0.0	0.0	108	1620.0												

SIGN SUMMARY SHEET

VERMONT AGENCY OF TRANSPORTATION

PROJECT NAME: STATEWIDE SOUTHEAST REGION
PROJECT NUMBER: STPG SIGN (31)

FILE NAME: WEATHERSFIELD EASTBOUND
PROJECT MANAGER: A. GAMBLE
DESIGNED BY: M. MILLER
WEATHERSFIELD VT-131 EB 4

PLOT DATE: 8/19/2010
DRAWN BY: M. MILLER
CHECKED BY: A. GAMBLE