DIRECTION	MILEPOINT	LOCATION CODE (SHEET 2)	SIGN CODE	WIDTH (IN)	HEIGHT (IN)	SHEETING REMARKS	SIGN LEGEND	NEW SIGNS "A"	NEW SIGNS "B"	EXISTING SIGNS RETAIN	EXISTING SIGNS SALVAGE FROM	EXISTING SIGNS SALVAGE TO	EXISTING SIGNS REMOVE	EXIST POST RETAIN	EXIST POST REMOVE	NUMBER OF NEW POSTS	SQUARE STEEL (IN) 1.75 (LB / FT) 1.88	SQUARE STEEL (IN) 2.00 (LB / FT) 2.42	SQUARE STEEL (IN) 2.50 (LB / FT) 3.35	TUBULAR STEEL Ø (IN) FOUNDATION	TUBULAR STEEL Ø (IN) 3.00 (LB / FT) 7.60	TUBULAR STEEL Ø (IN) 3.50 (LB / FT) 9.00	TUBULAR STEEL Ø (IN) 4.00 (LB / FT) 10.80	TUBULAR STEEL Ø (IN) 5.00 (LB / FT) 14.60	SIGN FRAME REQUIRED	REMARKS	SIGN DETAIL DETAIL IN SHS	SIGN DETAIL DETAIL ON SHEET NUMBER	SIGN DETAIL DETAIL ON STD SHEET NUMBER
WEATHERSFIELD WB							FY-FLUORESCENT YELLOW FYG-FLUORESCENT YELLOW GREEN																		"SHS"-STANDARD HIGHWAY SIGNS			
WB	5.093	F	VD-062AS	72	16		BUSINESS DIRECTORY SIGN			1				X											WEATHERSFIELD TRAIL ===>			
WB	5.015	G	VR-017	24	30								1		X										CASCADE FALLS RD (TH-79)			
		G	VR-017	24	30			5.00								1		14.25' X									6	
WB	5.007	H	R1-1	30	30		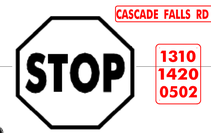 CASCADE FALLS RD TH79 - 2 EA. 1310 1420 0502						1		X			14.0'*	ON 9/16/11 THE STOP SIGN POST WAS DAMAGED IN AN ACCIDENT. A. GAMMELL, R.C.E., AUTHIRIZED										
		H	R1-1	30	30			6.25			3	3	3			1		12.0' X	THE REPLACEMENT OF THIS SIGN POST. 3 SIGNS WERE SALVAGED ONTO THE NEW POST. (PAY FOR REMOVALS)							X		
WB	4.993	F	M3-4	24	12			2.00								1		16.25' X							**GREEN ON WHITE**	X		
		F	M1-5	30	24			5.00																	INSTALL ASSEMBLY 75 FT ± WEST OF TH-79			E-136B
WB	4.480	F	W7-1B	30	30								1		X													
		F	W7-1A	30	30			6.25								1		15.0' X							W7-1B SIGN CODE IS FROM 2004 SHS; (2009 MUTCD WILL CALL THIS DESIGN A W7-1A)	X		
WB	4.310	F	S3-1	30	30		SCHOOL BUS STOP AHEAD						1		X													
WB	4.075	F	VD-062AS	72	16		BUSINESS DIRECTORY SIGN			1				X											CANVASWORKS ===>			
WB	3.998	G	VR-017	24	30								1		X										ASCUTNEY NOTCH RD (TH-79)			
		G	VR-017	24	30			5.00								1		12.75' X									6	
WB	3.992	H	R1-1	30	30		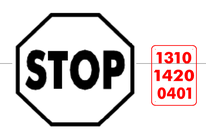 1310 1420 0401						1		X													
		H	R1-1	30	30			6.25								1		13.0' X								X		
							SHEET TOTALS	35.75	0.00	2	~~3~~ 0	~~3~~ 0	~~9~~ 6	0	0	6		~~97.25~~ ~~90~~										
								SF	SF	EA	EA	EA	EA	EA	EA	EA		FT										
							TOWN DIRECTIONAL TOTALS	644.2	0.0	17.0	1.0	1.0	153	0.0	0.0	78		1170.0										

SIGN SUMMARY SHEET

VERMONT AGENCY OF TRANSPORTATION

PROJECT NAME: STATEWIDE SOUTHEAST REGION
PROJECT NUMBER: STPG SIGN (31)

FILE NAME: WEATHERSFIELD WESTBOUND
PROJECT MANAGER: A. GAMBLE
DESIGNED BY: M. MILLER
WEATHERSFIELD VT-131 WB 14

PLOT DATE: 8/19/2010
DRAWN BY: M. MILLER
CHECKED BY: A. GAMBLE
SHEET 164 OF 175