DIRECTION	MILEPOINT	LOCATION CODE (SHEET 2)	SIGN CODE	WIDTH (IN)	HEIGHT (IN)	SHEETING REMARKS	SIGN LEGEND	NEW SIGNS "A"	NEW SIGNS "B"	EXISTING SIGNS RETAIN	EXISTING SIGNS SALVAGE FROM	EXISTING SIGNS SALVAGE TO	EXISTING SIGNS REMOVE	EXIST POST RETAIN	EXIST POST REMOVE	NUMBER OF NEW POSTS	SQUARE STEEL (IN) 1.75 (LB / FT) 1.88	SQUARE STEEL (IN) 2.00 (LB / FT) 2.42	SQUARE STEEL (IN) 2.50 (LB / FT) 3.35	FOUNDATION	TUBULAR STEEL Ø (IN) 3.00 (LB / FT) 7.60	TUBULAR STEEL Ø (IN) 3.50 (LB / FT) 9.00	TUBULAR STEEL Ø (IN) 4.00 (LB / FT) 10.80	TUBULAR STEEL Ø (IN) 5.00 (LB / FT) 14.60	SIGN FRAME REQUIRED	REMARKS	SIGN DETAIL: DETAIL IN SHS	SIGN DETAIL: DETAIL ON SHEET NUMBER	SIGN DETAIL: DETAIL ON STD SHEET NUMBER
WEATHERSFIELD WB							FY-FLUORESCENT YELLOW FYG-FLUORESCENT YELLOW GREEN																		"SHS"-STANDARD HIGHWAY SIGNS			
WB	2.157	F	R2-1	24	30								1		X													
		F	R2-1	24	30			5.00								1		15.0' X								X		
WB	2.065	F	S3-1	30	30		SCHOOL BUS STOP AHEAD						1		X													
WB	2.012	G	VR-017	24	30								1		X										AMSDEN SCHOOL RD (TH-10)			
		G	VR-017	24	30			5.00								1		12.75' X									6	
WB	2.006	H	R1-1	30	30		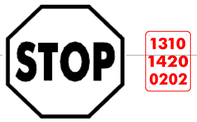						1		X													
		H	R1-1	30	30			6.25								1		13.25' X								X		
WB	1.987	F	W1-5R	30	30	FY	RIGHT WINDING CURVES			1				X														
		F	W7-3A	24	18	FY	NEXT 1/2 MILE (PLAQUE)			1																		
WB	1.771	F	R2-1	24	30								1		X													
		F	R2-1	24	30			5.00								1		10.0' X								X		
WB	1.675	F	VD-062B	72	16		BUSINESS DIRECTORY SIGN			1				X											ROCKLEDGE FARM ===>			
WB	1.637	F	VW-202	30	30		TRUCKS ENTERING						1		X													
		F	S3-1	30	30		SCHOOL BUS STOP AHEAD						1												SCHOOL BUS STOP AHEAD SIGN WILL NOT BE REPLACED			
		F	VW-202	30	30			6.25								1		12.75' X										E-154
							SHEET TOTALS	27.50	0.00	3	0	0	7	0	0	5		63.75 ~~75~~										
								SF	SF	EA	EA	EA	EA	EA	EA	EA		FT										
							TOWN DIRECTIONAL TOTALS	644.2	0.0	17.0	1.0	1.0	153	0.0	0.0	78		1170.0										

SIGN SUMMARY SHEET

VERMONT AGENCY OF TRANSPORTATION

PROJECT NAME: STATEWIDE SOUTHEAST REGION
PROJECT NUMBER: STPG SIGN (31)

FILE NAME: WEATHERSFIELD WESTBOUND
PROJECT MANAGER: A. GAMBLE
DESIGNED BY: M. MILLER
WEATHERSFIELD VT-131 WB 17

PLOT DATE: 8/19/2010
DRAWN BY: M. MILLER
CHECKED BY: A. GAMBLE