DIRECTION	MILEPOINT	LOCATION CODE (SHEET 2)	SIGN CODE	WIDTH (IN)	HEIGHT (IN)	SHEETING REMARKS	SIGN LEGEND	NEW SIGNS "A"	NEW SIGNS "B"	EXISTING SIGNS RETAIN	EXISTING SIGNS SALVAGE FROM	EXISTING SIGNS SALVAGE TO	EXISTING SIGNS REMOVE	EXIST POST RETAIN	EXIST POST REMOVE	NUMBER OF NEW POSTS	SQUARE STEEL (IN) (LB / FT) 1.75 / 1.88	SQUARE STEEL (IN) (LB / FT) 2.00 / 2.42	SQUARE STEEL (IN) (LB / FT) 2.50 / 3.35	FOUNDATION	TUBULAR STEEL Ø (IN) (LB / FT) 3.00 / 7.60	TUBULAR STEEL Ø (IN) (LB / FT) 3.50 / 9.00	TUBULAR STEEL Ø (IN) (LB / FT) 4.00 / 10.80	TUBULAR STEEL Ø (IN) (LB / FT) 5.00 / 14.60	SIGN FRAME REQUIRED	REMARKS	SIGN DETAIL: DETAIL IN SHS	SIGN DETAIL: DETAIL ON SHEET NUMBER	SIGN DETAIL: DETAIL ON STD SHEET NUMBER
SHAFTSBURY VT-7A							FY-FLUORESCENT YELLOW FYG-FLUORESCENT YELLOW GREEN																			"SHS"-STANDARD HIGHWAY SIGNS			
		F	M6-3	21	15			2.19																				E-136B
		F	M3-4S	24	12			2.00																				E-136B
		F	M1-5	24	24			4.00																				E-136B
		F	M6-1	21	15			2.19																				E-136B
SB	1.159	F	D2-1	72	10								1		X													
		F	M3-3S	24	12								1															
		F	VM-078S	24	12								1															
		F	M1-5	24	24		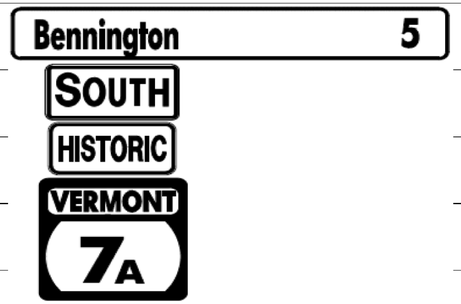						1															
		F	D2-1	72	12			6.00								2		16.25 17.75 X								GREEN ON WHITE ROUTE MARKERS.		5	
		F	M3-3	24	12			2.00																				E-136B
		F	VM-078	24	12			2.00																				E-136B
		F	M1-5	24	24			4.00																				E-136B
SB	1.133	F	R2-1	24	30								1	X														
		F	R2-1	30	36			7.50																		REPLACE SIGN AND INSTALL ON EXISTING POST.		4	
SB	1.094	F	D9-1	24	30		PHONE						1		X													
							SHEET TOTALS	31.88	0.00	0	0	0	6	0	0	2		~~30~~ 34.0										
								SF	SF	EA	EA	EA	EA	EA	EA	EA		FT										
							TOWN DIRECTIONAL TOTALS	217.7	0.0	26.0	5.0	5.0	46	0.0	0.0	38		570.0										

SIGN SUMMARY SHEET

VERMONT AGENCY OF TRANSPORTATION

PROJECT NAME: **STATEWIDE - SOUTHWEST REGION**
PROJECT NUMBER: **STPG SIGN(32)**
FILE NAME: **SHAFTSBURY SB.XLS**
PROJECT MANAGER: **A. GAMBLE**
DESIGNED BY: **J. KELLY**
PLOT DATE: **7/13/2010**
DRAWN BY: **J. KELLY**
CHECKED BY: **A. GAMBLE**
SHAFTSBURY SOUTHBOUND SHEET 6
SHEET **23** OF **90**