DIRECTION	MILEPOINT	LOCATION CODE (SHEET 2)	SIGN CODE	WIDTH (IN)	HEIGHT (IN)	SHEETING REMARKS	SIGN LEGEND	NEW SIGNS "A"	NEW SIGNS "B"	EXISTING SIGNS RETAIN	EXISTING SIGNS SALVAGE FROM	EXISTING SIGNS SALVAGE TO	EXISTING SIGNS REMOVE	EXIST POST RETAIN	EXIST POST REMOVE	NUMBER OF NEW POSTS	SQUARE STEEL (IN) (LB / FT) 1.75 / 1.88	SQUARE STEEL (IN) (LB / FT) 2.00 / 2.42	SQUARE STEEL (IN) (LB / FT) 2.50 / 3.35	TUBULAR STEEL Ø (IN) FOUNDATION	TUBULAR STEEL Ø (IN) (LB / FT) 3.00 / 7.60	TUBULAR STEEL Ø (IN) (LB / FT) 3.50 / 9.00	TUBULAR STEEL Ø (IN) (LB / FT) 4.00 / 10.80	TUBULAR STEEL Ø (IN) (LB / FT) 5.00 / 14.60	SIGN FRAME REQUIRED	REMARKS	SIGN DETAIL: DETAIL IN SHS	SIGN DETAIL: DETAIL ON SHEET NUMBER	SIGN DETAIL: DETAIL ON STD SHEET NUMBER
WINHALL VT-30							FY-FLUORESCENT YELLOW FYG-FLUORESCENT YELLOW GREEN																			"SHS"-STANDARD HIGHWAY SIGNS			
NB	10.086	A	VD-018	30	18		BONDVILLE / JCT VT-11 7						1		X											REMOVE BOTH OF THESE SIGN ASSEMBLIES FROM NORTH END OF JAMAICA.			
NB	10.106	A	R2-5A	24	30		REDUCED SPEED AHEAD						1		X														
WINHALL VT-30																													
NB	0.000	C	VD-024	60	7.5								~~1~~ 2		X											2 ADDITIONAL MM REMOVED @ 0.000			
		C	VD-025	60	7.5								~~1~~ 2		X														
		C	VD-024	72	10		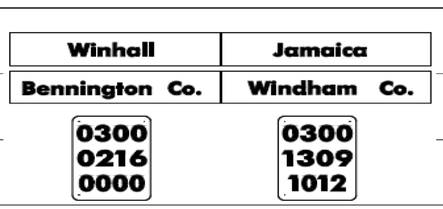	5.00								2	12.75 12.75 X								4		
		C	VD-025	72	10			5.00																		4		
		C	VD-700	6	10			0.42																		INSTALL ON LH POST BELOW WINHALL			E-138
		C	VD-700	6	10			0.42																		INSTALL ON RH POST BELOW JAMAICA			E-138
NB	0.015	A	W3-5	36	36			9.00								2	14.75 14.25 X									INSTALL 25 FEET NORTH OF TOWN'S WELCOME TO WINHALL SIGN.	X		
NB	0.065	A	VD-018	30	18			3.75								1	15.75 X									INSTALL ACROSS FROM SB BUSINESS SIGN			
NB	0.130	A	R2-1	24	30								1		X															
		A	R2-1	30	36			7.50								1	16.75 X										X		
NB	0.160	C	VR-017	24	30								1	X		1	13.25 X									AMEDEN RD. (TH-22) EXISTING POST DAMAGED			
		C	VR-017	24	30			5.00																		REPLACE SIGN AND RETAIN POST.		4	
							SHEET TOTALS	36.09 SF	0.00 SF	0 EA	0 EA	0 EA	~~8~~ 6 EA	0 EA	0 EA	~~7~~ 6 EA	~~90~~ 101.25 FT										
							TOWN DIRECTIONAL TOTALS	456.7	0.0	5.0	3.0	3.0	79	0.0	0.0	51	765.0												

SIGN SUMMARY SHEET

VERMONT AGENCY OF TRANSPORTATION

PROJECT NAME: STATEWIDE - SOUTHWEST REGION
PROJECT NUMBER: STPG SIGN(32)

FILE NAME: WINHALL NB.XLS
PROJECT MANAGER: A. GAMBLE
DESIGNED BY: J. KELLY
WINHALL NORTHBOUND SHEET 1

PLOT DATE: 8/26/2010
DRAWN BY: J. KELLY
CHECKED BY: A. GAMBLE
SHEET 27 OF 90