DIRECTION	MILEPOINT	LOCATION CODE (SHEET 2)	SIGN CODE	WIDTH (IN)	HEIGHT (IN)	SHEETING REMARKS	SIGN LEGEND	NEW SIGNS "A"	NEW SIGNS "B"	EXISTING SIGNS RETAIN	EXISTING SIGNS SALVAGE FROM	EXISTING SIGNS SALVAGE TO	EXISTING SIGNS REMOVE	EXIST POST RETAIN	EXIST POST REMOVE	NUMBER OF NEW POSTS	SQUARE STEEL (IN) 1.75 (LB / FT) 1.88	SQUARE STEEL (IN) 2.00 (LB / FT) 2.42	SQUARE STEEL (IN) 2.50 (LB / FT) 3.35	TUBULAR STEEL Ø (IN) FOUNDATION	TUBULAR STEEL Ø (IN) 3.00 (LB / FT) 7.60	TUBULAR STEEL Ø (IN) 3.50 (LB / FT) 9.00	TUBULAR STEEL Ø (IN) 4.00 (LB / FT) 10.80	TUBULAR STEEL Ø (IN) 5.00 (LB / FT) 14.60	SIGN FRAME REQUIRED	REMARKS	SIGN DETAIL: DETAIL IN SHS	SIGN DETAIL: DETAIL ON SHEET NUMBER	SIGN DETAIL: DETAIL ON STD SHEET NUMBER
WINHALL VT-30							FY-FLUORESCENT YELLOW FYG-FLUORESCENT YELLOW GREEN																				"SHS"-STANDARD HIGHWAY SIGNS			
		A	W2-4	30	30			6.25																			RETAIN FLASHING BEACON, POST AND WIRING.	X		
		A	W16-2	24	18			3.00																				X		
NB	7.447	A	M2-1	21	15								1	X																
		A	M1-5A	24	24								1																	
		A	M2-1	21	15			2.19																			INSTALL GREEN ON WHITE ROUTE MARKERS ON EXISTING POST.			E-136B
		A	M1-5	24	24			4.00																						E-136B
NB	7.520	A	W3-1	36	36		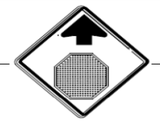						1		X															
		A	W3-1	36	36			9.00								2			15.5 15.75 X									X		
NB	7.560	A	D1-1A	72	10								1	X																
		A	D1-1S	72	10								1																	
		A	D1-1A	72	10		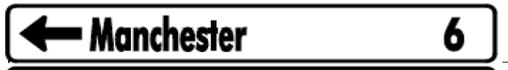						1																	
		A	D1-1A	72	10								1																	
		A	D1-1S	72	10								1																	
		A	D1-1A	72	12			6.00																			RETAIN EXISTING 3.50" DIAMETER STEEL POSTS. REUSE MOUNTING HARDWARE IF POSSIBLE.		5	
		A	D1-1S	72	12			6.00																					5	
SIGN SUMMARY SHEET							SHEET TOTALS	36.44	0.00	0	0	0	8	0	0	2			~~30~~ 31.25										
VERMONT AGENCY OF TRANSPORTATION								SF	SF	EA	EA	EA	EA	EA	EA	EA			FT										
							TOWN DIRECTIONAL TOTALS	456.7	0.0	5.0	3.0	3.0	79	0.0	0.0	51			765.0										

PROJECT NAME: **STATEWIDE - SOUTHWEST REGION**
PROJECT NUMBER: **STPG SIGN(32)**

FILE NAME: **WINHALL NB.XLS** PLOT DATE: **8/26/2010**
PROJECT MANAGER: **A. GAMBLE** DRAWN BY: **J. KELLY**
DESIGNED BY: **J. KELLY** CHECKED BY: **A. GAMBLE**
WINHALL NORTHBOUND SHEET 10 SHEET **36** OF **90**