| DIRECTION | MILEPOINT | LOCATION CODE (SHEET 2) | SIGN CODE | WIDTH (IN) | HEIGHT (IN) | SHEETING REMARKS | SIGN LEGEND | NEW SIGNS "A" | NEW SIGNS "B" | EXISTING SIGNS RETAIN | EXISTING SIGNS SALVAGE FROM | EXISTING SIGNS SALVAGE TO | EXISTING SIGNS REMOVE | EXIST POST RETAIN | EXIST POST REMOVE | NUMBER OF NEW POSTS | SQUARE STEEL (IN) 1.75 (LB/FT) 1.88 | SQUARE STEEL (IN) 2.00 (LB/FT) 2.42 | SQUARE STEEL (IN) 2.50 (LB/FT) 3.35 | TUBULAR STEEL Ø (IN) FOUNDATION | TUBULAR STEEL Ø (IN) 3.00 (LB/FT) 7.60 | TUBULAR STEEL Ø (IN) 3.50 (LB/FT) 9.00 | TUBULAR STEEL Ø (IN) 4.00 (LB/FT) 10.80 | TUBULAR STEEL Ø (IN) 5.00 (LB/FT) 14.60 | SIGN FRAME REQUIRED | REMARKS | SIGN DETAIL: DETAIL IN SHS | SIGN DETAIL: DETAIL ON SHEET NUMBER | SIGN DETAIL: DETAIL ON STD SHEET NUMBER |
|---|---|---|---|---|---|---|---|---|---|---|---|---|---|---|---|---|---|---|---|---|---|---|---|---|---|---|---|---|---|
| **WINHALL VT-30** | | | | | | | FY-FLUORESCENT YELLOW<br>FYG-FLUORESCENT YELLOW GREEN | | | | | | | | | | | | | | | | | | | | "SHS"-STANDARD HIGHWAY SIGNS | | | |
| SB | 3.454 | F | VW-054R | 30 | 30 | | HIDDEN DRIVE RIGHT | | | | | | 1 | | X | | | | | | | | | | | | | | |
| | | F | S3-1 | 30 | 30 | | SCHOOL BUS STOP AHEAD | | | | | | 1 | | | | | | | | | | | | | | | | |
| | | F | S3-1 | 36 | 36 | FYG | 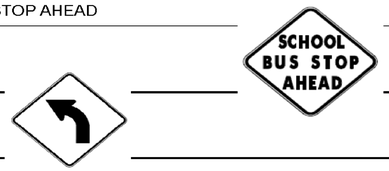 | 9.00 | | | | | | | | 2 | | 14.25<br>15.75<br>X | | | | | | | | | X | | |
| SB | 3.416 | F | W1-2L | 30 | 30 | | | 6.25 | | | | | | | | 1 | | 14.5<br>X | | | | | | | | INSTALL 200 FEET SOUTH OF EXISTING HIDDEN DRIVE RIGHT SIGN ASSEMBLY. | X | | |
| SB | 3.398 | F | W1-8 | 18 | 24 | | CHEVRON | | | | | | 1 | | X | | | | | | | | | | | | | | |
| SB | 3.385 | F | W1-6 | 48 | 24 | | | 8.00 | | | | | | | | 2 | | 13.0<br>13.0<br>X | | | | | | | | INSTALL 75 FEET SOUTH OF THE NORTHERN MOST CHEVRON. | X | | |
| SB | 3.341 | F | W1-8 | 18 | 24 | | CHEVRON | | | | | | 1 | | X | | | | | | | | | | | | | | |
| SB | 1.610 | G | VR-017 | 24 | 30 | | | | | | | | 1 | X | | | | | | | | | | | | | KENDALL FARM RD. (TH-15) | | | |
| | | G | VR-017 | 24 | 30 | | | 5.00 | | | | | | | | | | | | | | | | | | REPLACE SIGN AND RETAIN SIGN POST. | | 4 | |
| SB | 1.589 | H | R1-1 | 30 | 30 | | | | | | | | 1 | X | | | | | | | | | | | | | KENDALL FARM RD.(TH-15) | | | |
| | | H | R1-1 | 30 | 30 | | | 6.25 | | | | | | | | | | | | | | | | | | REPLACE SIGN AND RETAIN SIGN POST. | X | | |
| SB | 1.584 | G | VR-017 | 24 | 30 | | | | | | | | 1 | | X | | | | | | | | | | | | LOWER TAYLOR RD. (TH-3) | | | |
| | | G | VR-017 | 24 | 30 | | | 5.00 | | | | | | | | 1 | | 13.25<br>X | | | | | | | | INSTALL AT 20 FEET FROM VT-30 PER STANDARD | | 4 | |
| SB | 1.575 | H | R1-1 | 30 | 30 | | | | | | | | 1 | X | | | | | | | | | | | | | LOWER TAYLOR RD. (TH-3) | | | |
| | | H | R1-1 | 30 | 30 | | | 6.25 | | | | | | | | | | | | | | | | | | REPLACE SIGN AND RETAIN SIGN POST. | X | | |
| **SIGN SUMMARY SHEET** | | | | | | | SHEET TOTALS | 45.75 | 0.00 | 0 | 0 | 0 | 8 | 0 | 0 | 6 | | ~~90~~ 83.75 | | | | | | | | | | |
| VERMONT AGENCY OF TRANSPORTATION | | | | | | | | SF | SF | EA | EA | EA | EA | EA | EA | EA | | FT | | | | | | | | | | |
| | | | | | | | TOWN DIRECTIONAL TOTALS | 457.6 | 0.0 | 6.0 | 0.0 | 0.0 | 81 | 0.0 | 0.0 | 65 | | 975.0 | | | | | | | | | | |

PROJECT NAME: **STATEWIDE - SOUTHWEST REGION**
PROJECT NUMBER: **STPG SIGN(32)**

FILE NAME: **WINHALL SB.XLS** PLOT DATE: **7/13/2010**
PROJECT MANAGER: **A. GAMBLE** DRAWN BY: **J. KELLY**
DESIGNED BY: **J. KELLY** CHECKED BY: **A. GAMBLE**
WINHALL SOUTHBOUND SHEET 7 SHEET **45** OF **90**