DIRECTION	MILEPOINT	LOCATION CODE (SHEET 2)	SIGN CODE	WIDTH (IN)	HEIGHT (IN)	SHEETING REMARKS	SIGN LEGEND	NEW SIGNS "A"	NEW SIGNS "B"	EXISTING SIGNS RETAIN	EXISTING SIGNS SALVAGE FROM	EXISTING SIGNS SALVAGE TO	EXISTING SIGNS REMOVE	EXIST POST RETAIN	EXIST POST REMOVE	NUMBER OF NEW POSTS	SQUARE STEEL (IN) (LB / FT) 1.75 / 1.88	SQUARE STEEL (IN) (LB / FT) 2.00 / 2.42	SQUARE STEEL (IN) (LB / FT) 2.50 / 3.35	TUBULAR STEEL Ø (IN) FOUNDATION	TUBULAR STEEL Ø (IN) (LB / FT) 3.00 / 7.60	TUBULAR STEEL Ø (IN) (LB / FT) 3.50 / 9.00	TUBULAR STEEL Ø (IN) (LB / FT) 4.00 / 10.80	TUBULAR STEEL Ø (IN) (LB / FT) 5.00 / 14.60	SIGN FRAME REQUIRED	REMARKS	SIGN DETAIL: DETAIL IN SHS	SIGN DETAIL: DETAIL ON SHEET NUMBER	SIGN DETAIL: DETAIL ON STD SHEET NUMBER
WINHALL VT-30							FY-FLUORESCENT YELLOW FYG-FLUORESCENT YELLOW GREEN																			"SHS"-STANDARD HIGHWAY SIGNS			
SB	1.540	F	R2-5A	24	30		REDUCED SPEED AHEAD						1		X														
SB	1.500	F	W3-5	36	36			9.00								2		15.0 15.75 X									INSTALL 200 FEET SOUTH OF EXISTING REDUCED SPEED AHEAD ASSEMBLY.	X		
SB	1.400	F	R2-1	24	30								1		X															
		F	R2-1	30	36			7.50								1		15.75 X											4	
SB	1.350	F	W2-2L	30	30		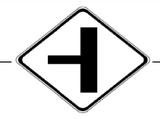						1		X														
		F	W2-2LM	30	30			6.25								1		14.25 X											6	
SB	1.243	F	S1-1	36	36								1		X														
		F	W16-9FYG	24	10								1																
		F	S1-1	36	36	FYG		9.00								2		13.75 13.75 X										X		
		F	S4-3P	24	8	FYG		1.33																				X		
SB	1.190	F	D1-1E	72	20								2 ~~1~~		X															
		F	D1-1E	72	20			10.00								2		12.5 13.75 X									EXISTING SIGN WAS TWO SIGNS PLACED TO MAKE ONE		6	
SB	1.140	F	VW-544	30	30								1		X														
		F	VW-544	30	30			6.25								1		14.0 X											6	
SB	1.000	F	R2-1	24	30								1		X															
							SHEET TOTALS	49.33	0.00	0	0	0	~~9~~ 8	0	0	9		~~135~~ 128.5											
								SF	SF	EA	EA	EA	EA	EA	EA	EA		FT											
							TOWN DIRECTIONAL TOTALS	457.6	0.0	6.0	0.0	0.0	81	0.0	0.0	65		975.0											

SIGN SUMMARY SHEET

VERMONT AGENCY OF TRANSPORTATION

PROJECT NAME: STATEWIDE - SOUTHWEST REGION
PROJECT NUMBER: STPG SIGN(32)

FILE NAME: WINHALL SB.XLS
PROJECT MANAGER: A. GAMBLE
DESIGNED BY: J. KELLY
WINHALL SOUTHBOUND SHEET 8

PLOT DATE: 7/13/2010
DRAWN BY: J. KELLY
CHECKED BY: A. GAMBLE
SHEET 46 OF 90