DIRECTION	MILEPOINT	LOCATION CODE (SHEET 2)	SIGN CODE	WIDTH (IN)	HEIGHT (IN)	SHEETING REMARKS	SIGN LEGEND	NEW SIGNS "A"	NEW SIGNS "B"	EXISTING SIGNS RETAIN	EXISTING SIGNS SALVAGE FROM	EXISTING SIGNS SALVAGE TO	EXISTING SIGNS REMOVE	EXIST POST RETAIN	EXIST POST REMOVE	NUMBER OF NEW POSTS	SQUARE STEEL (IN) 1.75 (LB / FT) 1.88	SQUARE STEEL (IN) 2.00 (LB / FT) 2.42	SQUARE STEEL (IN) 2.50 (LB / FT) 3.35	FOUNDATION	TUBULAR STEEL Ø (IN) 3.00 (LB / FT) 7.60	TUBULAR STEEL Ø (IN) 3.50 (LB / FT) 9.00	TUBULAR STEEL Ø (IN) 4.00 (LB / FT) 10.80	TUBULAR STEEL Ø (IN) 5.00 (LB / FT) 14.60	SIGN FRAME REQUIRED	REMARKS	SIGN DETAIL: DETAIL IN SHS	SIGN DETAIL: DETAIL ON SHEET NUMBER	SIGN DETAIL: DETAIL ON STD SHEET NUMBER
DORSET US-7							FY-FLUORESCENT YELLOW FYG-FLUORESCENT YELLOW GREEN																			"SHS"-STANDARD HIGHWAY SIGNS			
		B	R8-3	24	24			4.00																			X		
NB	2.103	C	VR-017	24	30								1	X												MAD TOM RD. (TH-5)			
		C	VR-017	24	30			5.00																		REPLACE SIGN AND RETAIN SIGN POST.		4	
NB	2.111	D	R1-1	30	30								1	X												MAD TOM RD. (TH-5)			
		D	R1-1	30	30			6.25																		REPLACE SIGN AND RETAIN SIGN POST.	X		
			N/A				TOWN'S STREET NAME SIGN			X																			
NB	2.121	A	R8-3A	24	24								1		X														
		A	M4-6P	24	12		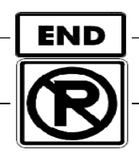						1																
		A	M4-6	24	12			2.00								1		14.25 X								BLACK ON WHITE		4	
		A	R8-3	24	24			4.00																			X		
NB	2.148	A	M3-1	24	12								1	X															
		A	M1-4	24	24								1																
		A	M3-1	24	12			2.00																		REPLACE THE BLACK ON WHITE ROUTE MARKERS AND RETAIN THE SIGN POST.	X		
		A	M1-4	24	24			4.00																			X		
NB	2.268	A	R2-1	24	30								1		X														
							SHEET TOTALS	27.25	0.00	0	0	0	7	0	0	1		~~15~~ 14.25											
								SF	SF	EA	EA	EA	EA	EA	EA	EA		FT											
							TOWN DIRECTIONAL TOTALS	163.8	0.0	1.0	1.0	1.0	32	0.0	0.0	24		360.0											

SIGN SUMMARY SHEET

VERMONT AGENCY OF TRANSPORTATION

PROJECT NAME: STATEWIDE - SOUTHWEST REGION
PROJECT NUMBER: STPG SIGN(32)

FILE NAME: DORSET NB.XLS
PROJECT MANAGER: A. GAMBLE
DESIGNED BY: J. KELLY
DORSET NORTHBOUND SHEET 2

PLOT DATE: 7/13/2010
DRAWN BY: J. KELLY
CHECKED BY: A. GAMBLE
SHEET 52 OF 90