DIRECTION	MILEPOINT	LOCATION CODE (SHEET 2)	SIGN CODE	WIDTH (IN)	HEIGHT (IN)	SHEETING REMARKS	SIGN LEGEND	NEW SIGNS "A"	NEW SIGNS "B"	EXISTING SIGNS RETAIN	EXISTING SIGNS SALVAGE FROM	EXISTING SIGNS SALVAGE TO	EXISTING SIGNS REMOVE	EXIST POST RETAIN	EXIST POST REMOVE	NUMBER OF NEW POSTS	SQUARE STEEL (IN) (LB / FT) 1.75 / 1.88	SQUARE STEEL (IN) (LB / FT) 2.00 / 2.42	SQUARE STEEL (IN) (LB / FT) 2.50 / 3.35	TUBULAR STEEL Ø (IN) FOUNDATION	TUBULAR STEEL Ø (IN) (LB / FT) 3.00 / 7.60	TUBULAR STEEL Ø (IN) (LB / FT) 3.50 / 9.00	TUBULAR STEEL Ø (IN) (LB / FT) 4.00 / 10.80	TUBULAR STEEL Ø (IN) (LB / FT) 5.00 / 14.60	SIGN FRAME REQUIRED	REMARKS	SIGN DETAIL: DETAIL IN SHS	SIGN DETAIL: DETAIL ON SHEET NUMBER	SIGN DETAIL: DETAIL ON STD SHEET NUMBER
DORSET US-7							FY-FLUORESCENT YELLOW FYG-FLUORESCENT YELLOW GREEN																			"SHS"-STANDARD HIGHWAY SIGNS			
		E	OM-3L	12	36			3.00								1		11.0 X									X		
SB	3.345	F	N/A	30	30		(HORSE SHOW - SEASONAL SIGN)			1				X														
SB	3.261	F	R2-1	24	30								1		X														
		F	R2-1	24	30			5.00								1		14.5 X									X		
SB	2.402	F	W3-5	36	36		SPEED REDUCTION (40)			1				X														
SB	2.330	F	VD-018	30	18								1	X															
		F	VD-018	30	18			3.75																			REPLACE SIGN AND RETAIN SIGN POST.		5	
SB	2.279	G	VR-017	24	30								1	X													COOK RD. (TH-40)			
		G	VR-017	24	30			5.00																			REPLACE SIGN AND RETAIN SIGN POST.		4	
SB	2.272	H	R1-1	30	30								1		X													COOK RD. (TH-40)			
		H	R1-1	30	30			6.25								1		13.25 X									X		
SB	2.265	F	R2-1	24	30								1	X															
		F	R2-1	30	36			7.50																			REPLACE SIGN AND RETAIN SIGN POST.		4	
SB	2.219	F	W2-1Mb	30	30		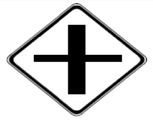						1		X														
		F	W2-1Mb	36	36			9.00								2		15.5 15.75 X										6	
SIGN SUMMARY SHEET							SHEET TOTALS	39.50	0.00	2	0	0	6	0	0	5		~~75~~ 70										
								SF	SF	EA	EA	EA	EA	EA	EA	EA		FT										
VERMONT AGENCY OF TRANSPORTATION							TOWN DIRECTIONAL TOTALS	206.7	0.0	5.0	1.0	1.0	47	0.0	0.0	21		315.0										

PROJECT NAME: STATEWIDE - SOUTHWEST REGION
PROJECT NUMBER: STPG SIGN(32)

FILE NAME: DORSET SB.XLS
PROJECT MANAGER: A. GAMBLE
DESIGNED BY: J. KELLY
DORSET SOUTHBOUND SHEET 4

PLOT DATE: 7/13/2010
DRAWN BY: J. KELLY
CHECKED BY: A. GAMBLE
SHEET 59 OF 90