DIRECTION	MILEPOINT	LOCATION CODE (SHEET 2)	SIGN CODE	WIDTH (IN)	HEIGHT (IN)	SHEETING REMARKS	SIGN LEGEND	NEW SIGNS "A"	NEW SIGNS "B"	EXISTING SIGNS RETAIN	EXISTING SIGNS SALVAGE FROM	EXISTING SIGNS SALVAGE TO	EXISTING SIGNS REMOVE	EXIST POST RETAIN	EXIST POST REMOVE	NUMBER OF NEW POSTS	SQUARE STEEL (IN) (LB / FT) 1.88 (1.75)	2.42 (2.00)	3.35 (2.50)	TUBULAR STEEL Ø (IN) (LB / FT) FOUNDATION	7.60 (3.00)	9.00 (3.50)	10.80 (4.00)	14.60 (5.00)	SIGN FRAME REQUIRED	REMARKS	SIGN DETAIL DETAIL IN SHS	DETAIL ON SHEET NUMBER	DETAIL ON STD SHEET NUMBER
DORSET US-7							FY-FLUORESCENT YELLOW FYG-FLUORESCENT YELLOW GREEN																			"SHS"-STANDARD HIGHWAY SIGNS			
			M1-5	24	24			4.00																					E-136B
SB	1.779	F	D1-1A	72	10								1		X														
		F	D1-1A	72	10								1																
		F	D1-1A	72	10								1																
		F	D1-1A	72	10								1																
		F	D1-1A	72	12		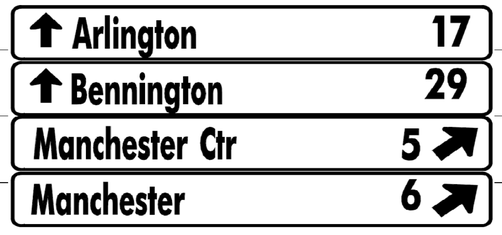	6.00								2		15.5 16.75 X										5	
		F	D1-1A	72	12			6.00																				5	
		F	D1-1A	72	12			6.00																				5	
		F	D1-1A	72	12			6.00																				5	
							SHEET TOTALS	28.00	0.00	0	0	0	4	0	0	2		~~30~~ 32.25											
								SF	SF	EA	EA	EA	EA	EA	EA	EA		FT											
							TOWN DIRECTIONAL TOTALS	206.7	0.0	5.0	1.0	1.0	48 ~~47~~	0.0	0.0	21		294.5 ~~315.0~~											

SIGN SUMMARY SHEET

VERMONT AGENCY OF TRANSPORTATION

PROJECT NAME: STATEWIDE - SOUTHWEST REGION
PROJECT NUMBER: STPG SIGN(32)

FILE NAME: DORSET SB.XLS
PROJECT MANAGER: A. GAMBLE
DESIGNED BY: J. KELLY
DORSET SOUTHBOUND SHEET 7

PLOT DATE: 7/13/2010
DRAWN BY: J. KELLY
CHECKED BY: A. GAMBLE
SHEET 62 OF 90