DIRECTION	MILEPOINT	LOCATION CODE (SHEET 2)	SIGN CODE	WIDTH (IN)	HEIGHT (IN)	SHEETING REMARKS	SIGN LEGEND	NEW SIGNS "A"	NEW SIGNS "B"	EXISTING SIGNS RETAIN	EXISTING SIGNS SALVAGE FROM	EXISTING SIGNS SALVAGE TO	EXISTING SIGNS REMOVE	EXIST POST RETAIN	EXIST POST REMOVE	NUMBER OF NEW POSTS	SQUARE STEEL (IN) (LB / FT) 1.75 / 1.88	SQUARE STEEL (IN) (LB / FT) 2.00 / 2.42	SQUARE STEEL (IN) (LB / FT) 2.50 / 3.35	TUBULAR STEEL Ø (IN) FOUNDATION	TUBULAR STEEL Ø (IN) (LB / FT) 3.00 / 7.60	TUBULAR STEEL Ø (IN) (LB / FT) 3.50 / 9.00	TUBULAR STEEL Ø (IN) (LB / FT) 4.00 / 10.80	TUBULAR STEEL Ø (IN) (LB / FT) 5.00 / 14.60	SIGN FRAME REQUIRED	REMARKS	SIGN DETAIL: DETAIL IN SHS	SIGN DETAIL: DETAIL ON SHEET NUMBER	SIGN DETAIL: DETAIL ON STD SHEET NUMBER
MOUNT TABOR US-7							FY-FLUORESCENT YELLOW FYG-FLUORESCENT YELLOW GREEN																			"SHS"-STANDARD HIGHWAY SIGNS			
		A	VD-062AS	72	16		BUSINESS SIGN			1																		
NB	2.612	A	R2-1	24	30								1		X													
NB	2.620	A	R2-1	30	36			7.50								1		15.5 X									INSTALL 40 FEET NORTH OF EXISTING SL45 SIGN ASSEMBLY.		4	
NB	2.653	A	W11-2	30	30								1		X													
		A	VW-113	24	18		HANDICAPPED PERSON						1															
NB	2.660	A	W11-2	30	30	FYG		6.25								1		15.25 X									INSTALL 35 FEET NORTH OF EXISTING PEDESTRIAN ASSEMBLY.	X		
		A	W16-9P	24	12	FYG		2.00																				X		
NB	2.700	A	W2-1M	48	48								1		X													
		A	W13-1	24	24		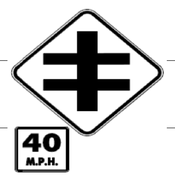						1															
		A	W2-1M	48	48			16.00								2		17.0 17.25 X										6	
		A	W13-1	24	24			4.00																				X		
NB	2.822	D	R1-1	30	30								1		X												DEPOT RD. EXT. (TH-6)			
		D	R1-1	30	30			6.25								1		13.75 X										X		
		C	VR-017	24	30			5.00								~~1~~		~~X~~									INSTALL BACK TO BACK WITH STOP SIGN.		4	
			N/A				TOWN'S STREET NAME SIGN				1	1	1														REINSTALL TOWN'S STREET NAME SIGN ON TOP OF POST.			
							SHEET TOTALS	47.00	0.00	1	1	1	~~6~~ 7	0	0	~~6~~ 5		~~90~~ 78.75											
								SF	SF	EA	EA	EA	EA	EA	EA	EA		FT											
							TOWN DIRECTIONAL TOTALS	134.1	0.0	7.0	2.0	2.0	29	0.0	0.0	18		270.0											

SIGN SUMMARY SHEET

VERMONT AGENCY OF TRANSPORTATION

PROJECT NAME: **STATEWIDE - SOUTHWEST REGION**
PROJECT NUMBER: **STPG SIGN(32)**

FILE NAME: **MOUNT TABOR NB.XLS** PLOT DATE: **8/26/2010**
PROJECT MANAGER: **A. GAMBLE** DRAWN BY: **J. KELLY**
DESIGNED BY: **J. KELLY** CHECKED BY: **A. GAMBLE**
MOUNT TABOR NORTHBOUND SHEET 3 SHEET **65** OF **90**