DIRECTION	MILEPOINT	LOCATION CODE (SHEET 2)	SIGN CODE	WIDTH (IN)	HEIGHT (IN)	SHEETING REMARKS	SIGN LEGEND	NEW SIGNS "A"	NEW SIGNS "B"	EXISTING SIGNS RETAIN	EXISTING SIGNS SALVAGE FROM	EXISTING SIGNS SALVAGE TO	EXISTING SIGNS REMOVE	EXIST POST RETAIN	EXIST POST REMOVE	NUMBER OF NEW POSTS	SQUARE STEEL (IN) 1.75 (LB/FT) 1.88	SQUARE STEEL (IN) 2.00 (LB/FT) 2.42	SQUARE STEEL (IN) 2.50 (LB/FT) 3.35	TUBULAR STEEL Ø (IN) FOUNDATION	TUBULAR STEEL Ø (IN) 3.00 (LB/FT) 7.60	TUBULAR STEEL Ø (IN) 3.50 (LB/FT) 9.00	TUBULAR STEEL Ø (IN) 4.00 (LB/FT) 10.80	TUBULAR STEEL Ø (IN) 5.00 (LB/FT) 14.60	SIGN FRAME REQUIRED	REMARKS	SIGN DETAIL: DETAIL IN SHS	SIGN DETAIL: DETAIL ON SHEET NUMBER	SIGN DETAIL: DETAIL ON STD SHEET NUMBER
MOUNT TABOR US-7							FY-FLUORESCENT YELLOW FYG-FLUORESCENT YELLOW GREEN																			"SHS"-STANDARD HIGHWAY SIGNS			
SB	3.025	F	D1-1	72	10								1		X														
		F	D1-1	72	10		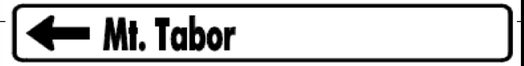						1																
		F	D1-1	72	12		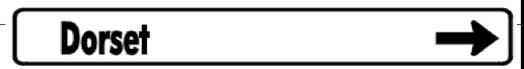	6.00								2		13.5 14.25 X								5	
		F	D1-1	72	12			6.00																		SIGN SHOULD READ DANBY		5	
SB	3.003	F	OM-3R	12	36								1		X														
		F	OM-3R	12	36			3.00								1		11.0 X									X		
SB	2.985	E	OM-3L	12	36								1		X														
		E	OM-3L	12	36			3.00								1		11.0 X									X		
SB	2.929	G	VR-017	24	30								1	X													MT. TABOR AVE. (TH-1)			
		G	VR-017	24	30			5.00																		REPLACE SIGN AND RETAIN SIGN POST.		4	
SB	2.921	H	R1-1	30	30								2 ~~1~~														MT. TABOR AVE. (TH-1)			
		H	R1-1	30	30			6.25			I	I			X	1		13.5 X								REPLACE SIGN AND RETAIN SIGN POST. NEW POST WAS INSTALLED	X		
SB	2.817	G	VR-017	24	30			5.00								1		14.5 X										4	
SB	2.810	H	R1-1	30	30						I	I	2 ~~1~~		X												DEPOT RD. (TH-6)			
		H	R1-1	30	30			6.25								1		13.5 X								DEPOT RD SIGN WAS SALVAGED	X		
SIGN SUMMARY SHEET							SHEET TOTALS	40.50	0.00	0	~~2 0~~	~~2 0~~	~~9 7~~	0	0	~~7 6~~		~~90~~ 91.25											
								SF	SF	EA	EA	EA	EA	EA	EA	EA		FT											
VERMONT AGENCY OF TRANSPORTATION							TOWN DIRECTIONAL TOTALS	173.3	0.0	7.0	2.0	2.0	32	0.0	0.0	17		255.0											

PROJECT NAME: STATEWIDE - SOUTHWEST REGION
PROJECT NUMBER: STPG SIGN(32)
FILE NAME: MOUNT TABOR SB.XLS
PROJECT MANAGER: A. GAMBLE
DESIGNED BY: J. KELLY
PLOT DATE: 8/26/2010
DRAWN BY: J. KELLY
CHECKED BY: A. GAMBLE
MOUNT TABOR SOUTHBOUND SHEET 2