DIRECTION	MILEPOINT	LOCATION CODE (SHEET 2)	SIGN CODE	WIDTH (IN)	HEIGHT (IN)	SHEETING REMARKS	SIGN LEGEND	NEW SIGNS "A"	NEW SIGNS "B"	EXISTING SIGNS RETAIN	EXISTING SIGNS SALVAGE FROM	EXISTING SIGNS SALVAGE TO	EXISTING SIGNS REMOVE	EXIST POST RETAIN	EXIST POST REMOVE	NUMBER OF NEW POSTS	SQUARE STEEL (IN) (LB / FT) 1.75 / 1.88	SQUARE STEEL (IN) (LB / FT) 2.00 / 2.42	SQUARE STEEL (IN) (LB / FT) 2.50 / 3.35	TUBULAR STEEL Ø (IN) FOUNDATION	TUBULAR STEEL Ø (IN) (LB / FT) 3.00 / 7.60	TUBULAR STEEL Ø (IN) (LB / FT) 3.50 / 9.00	TUBULAR STEEL Ø (IN) (LB / FT) 4.00 / 10.80	TUBULAR STEEL Ø (IN) (LB / FT) 5.00 / 14.60	SIGN FRAME REQUIRED	REMARKS	SIGN DETAIL: DETAIL IN SHS	SIGN DETAIL: DETAIL ON SHEET NUMBER	SIGN DETAIL: DETAIL ON STD SHEET NUMBER
STOCKBRIDGE VT-107							FY-FLUORESCENT YELLOW FYG-FLUORESCENT YELLOW GREEN																			"SHS"-STANDARD HIGHWAY SIGNS			
		F	D1-1A	72	10		<--- (45 DEG) RUTLAND 22			1																		
		F	D1-1A	72	10		ROCHESTER 9 --->			1																		
WB	0.059	F	M3-3	24	12								1		X													
		F	M1-5A	30	24								1															
		F	M6-3	21	15		UP ARROW						1															
		F	M3-1	24	12								1															
		F	M1-5A	30	24								1															
		F	M6-1	21	15								1															
		F	M3-3	24	12		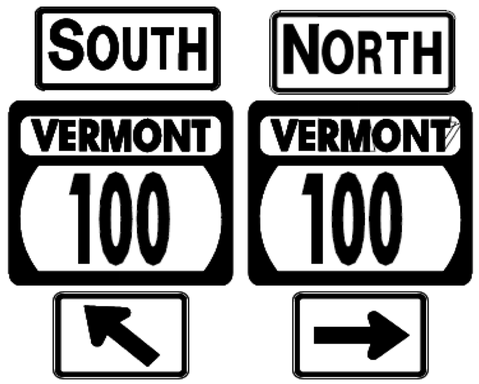	2.00								2		17.0 17.25 X						#2B	GREEN ON WHITE ROUTE MARKERS.		7	E-136B
		F	M1-5	30	24			5.00																				E-136B
		F	M6-2L	21	15			2.19																				E-136B
		F	M3-1	24	12			2.00																				E-136B
		F	M1-5	30	24			5.00																				E-136B
		F	M6-1	21	15			2.19																				E-136B
							SHEET TOTALS	18.38	0.00	2	0	0	6	0	0	2		~~30~~ 34.25										
								SF	SF	EA	EA	EA	EA	EA	EA	EA		FT										
							TOWN DIRECTIONAL TOTALS	151.3	0.0	22.0	0.0	0.0	35	0.0	0.0	20		299.75 ~~300.0~~										

SIGN SUMMARY SHEET

VERMONT AGENCY OF TRANSPORTATION

PROJECT NAME: **STATEWIDE - SOUTHWEST REGION**
PROJECT NUMBER: **STPG SIGN(32)**

FILE NAME: **STOCKBRIDGE WB.XLS** PLOT DATE: **7/13/2010**
PROJECT MANAGER: **A. GAMBLE** DRAWN BY: **J. KELLY**
DESIGNED BY: **J. KELLY** CHECKED BY: **A. GAMBLE**
STOCKBRIDGE WESTBOUND SHEET 6 SHEET **87** OF **90**