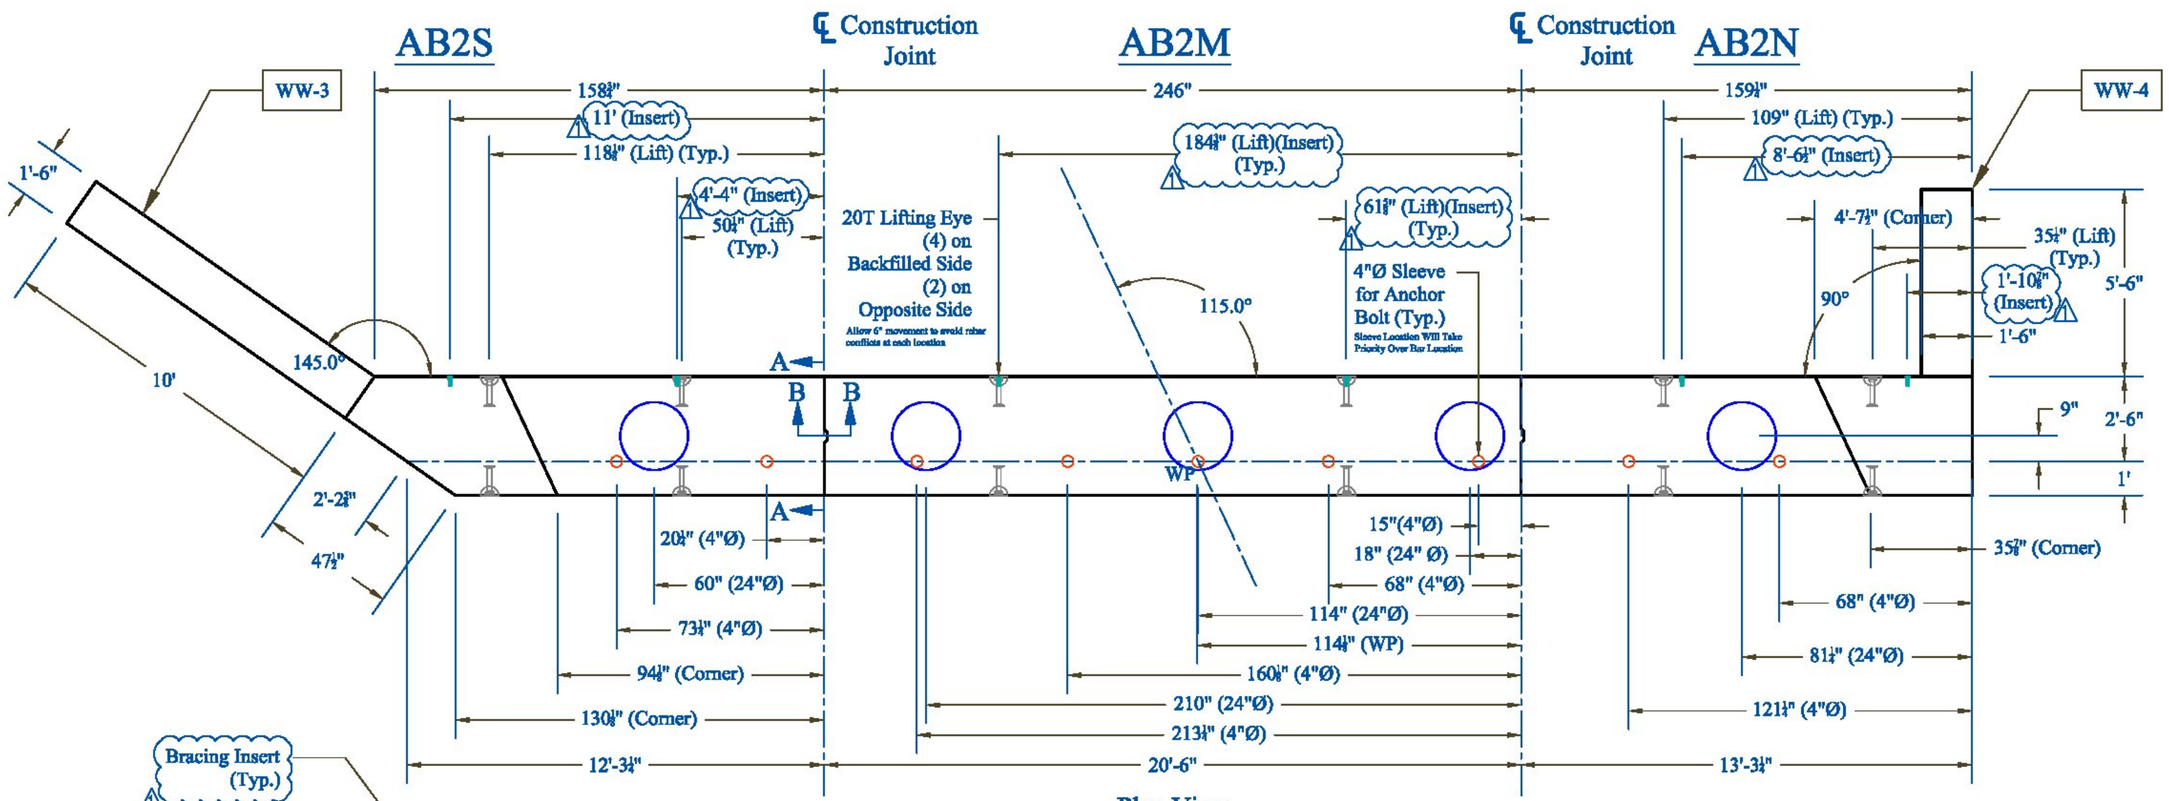

Plan View

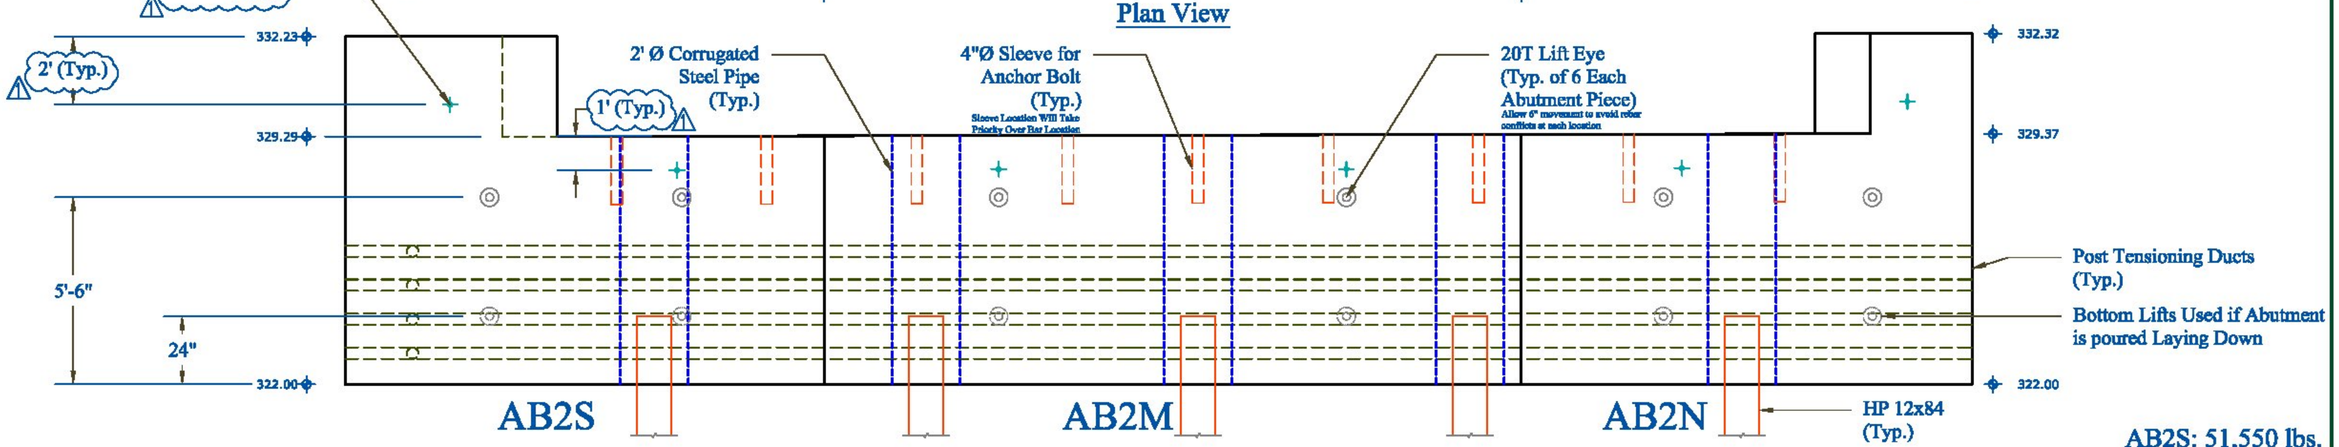

Elevation View

AB2S: 51,550 lbs.
AB2M: 67,500 lbs
AB2N: 53,050 lbs

CONTRACTORS VTSPE:

Vermont Agency of Transportation
RECEIVED
CK'D BY MEM OK'D BY CWC
Apr. 17, 2015
RESUBMIT APPROVED ✓
BY C. Carlson DATE 04-17-2015

Rev.	Date	By	Description
1	04/16/15	IBA	Changes per State Review

PRECAST CONCRETE ABUTMENT SHOP DRAWINGS (SDI JOB #15264)

SUPERVISOR: M. WHEELER
DETAILER: I. ADAMS
CHECKER: E. Barendse
ENGINEER: VTAOT

PROJECT NAME: Bristol BRF 021-1(29)
PROJECT #: 021-1(29)
LOCATION: Bristol, VT

INSTALLER:
S.D. Ireland Concrete
193 Industrial Ave
Williston, VT 05495

FABRICATOR:
193 INDUSTRIAL AVE.
WILLISTON, VT 05495
Ph: (802) 658-0201

SD Ireland PRECAST

03/17/2015 | ABUTMENT_2 | 3_OF_16