WW1: Plan View

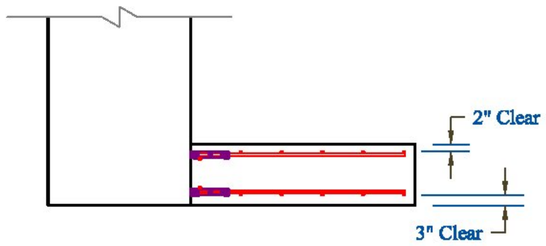

Note: Reference reinforcing schedule for bar dimensions and quantities. Piece drawing may not reflect actual bar order.

WW2: Plan View

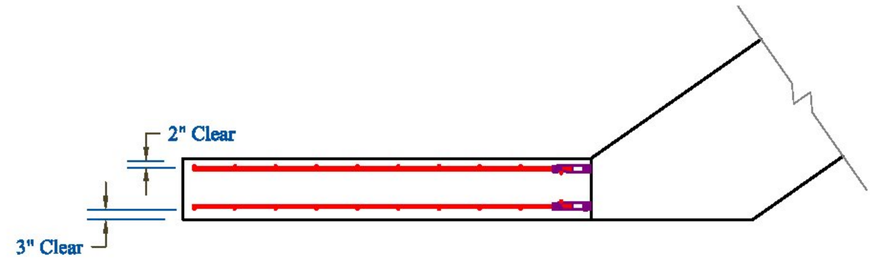

Note: Reference reinforcing schedule for bar dimensions and quantities. Piece drawing may not reflect actual bar order.

WW1: Elevation View

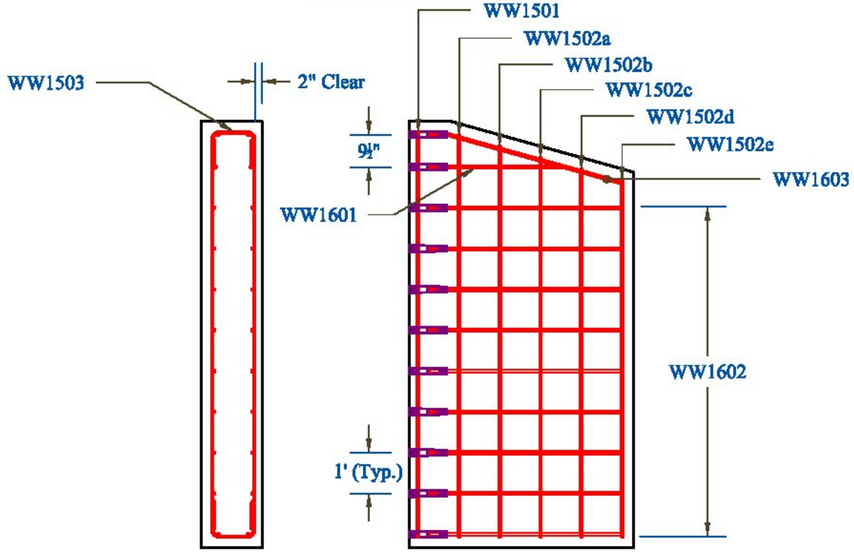

3" Clear U.O.N.

WW2: Elevation View

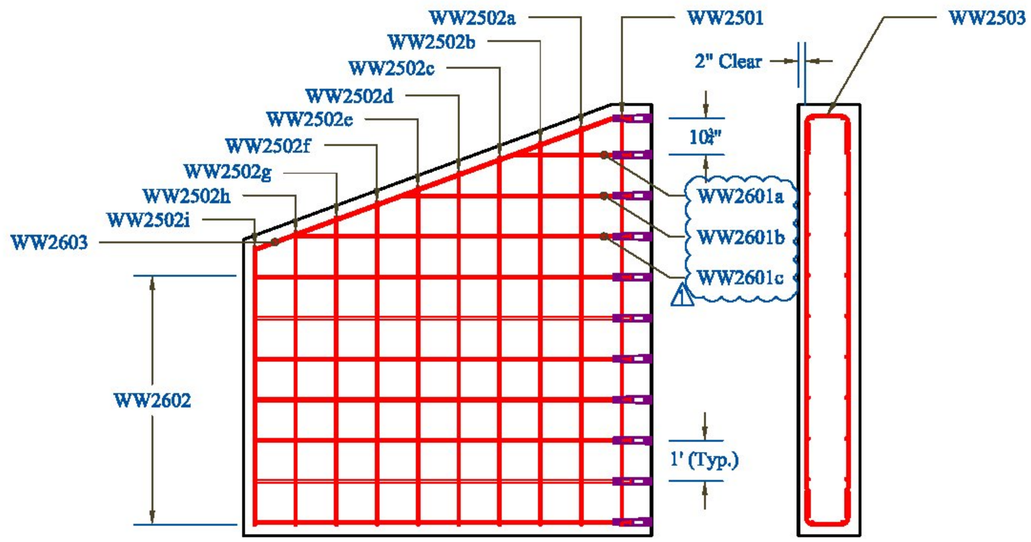

3" Clear U.O.N.

CONTRACTORS VTSPE:	Vermont Agency of Transportation RECEIVED CK'D BY MEM OK'D BY CWC Apr. 17, 2015 RESUBMIT APPROVED ✓ BY C. Carlson DATE 04-17-2015	Rev.	Date	By	Description
		1	04/16/15	IBA	Changes per State Review

PRECAST CONCRETE ABUTMENT SHOP DRAWINGS (SDI JOB #15264)

SUPERVISOR: M. WHEELER
DETAILER: I. ADAMS
CHECKER: E. Barendse
ENGINEER: VTAOT

PROJECT NAME: Bristol BRF 021-1(29)
PROJECT #: 021-1(29)
LOCATION: Bristol, VT

INSTALLER: S.D. Ireland Concrete, 193 Industrial Ave, Williston, VT 05495

FABRICATOR: 193 INDUSTRIAL AVE. WILLISTON, VT 05495 Ph: (802) 658-0201

SD Ireland PRECAST

03/17/2015 | WINGWALLS_1 | 13_OF_16