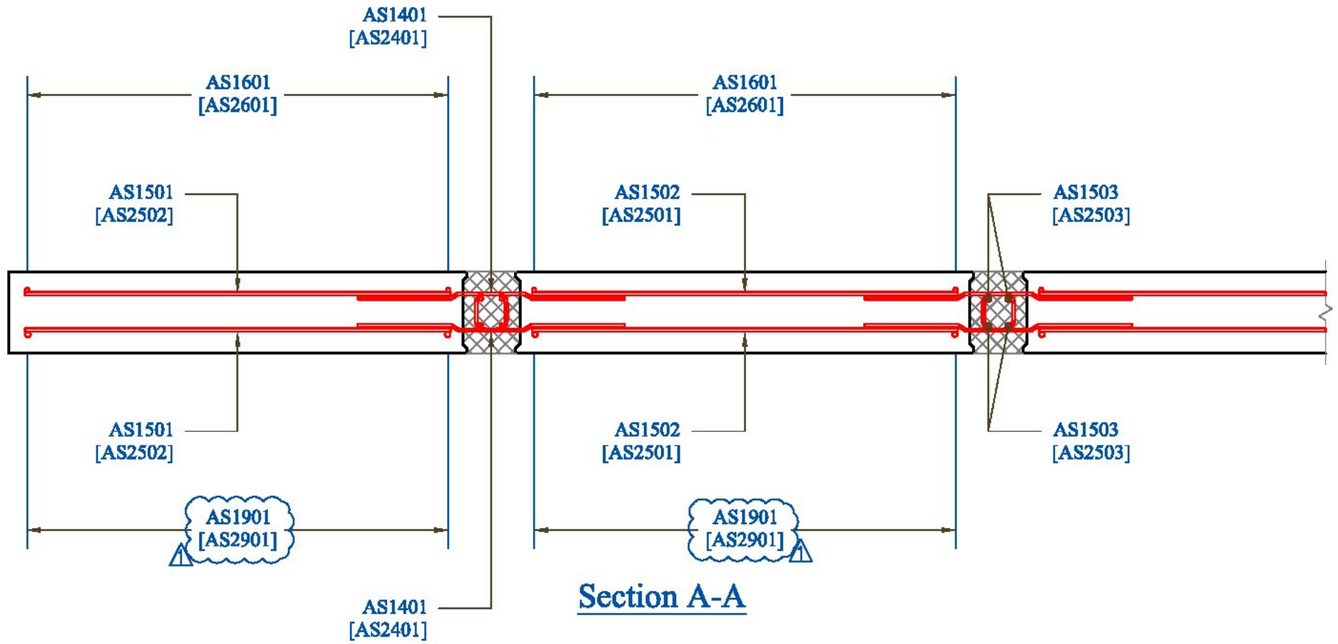

Section A-A

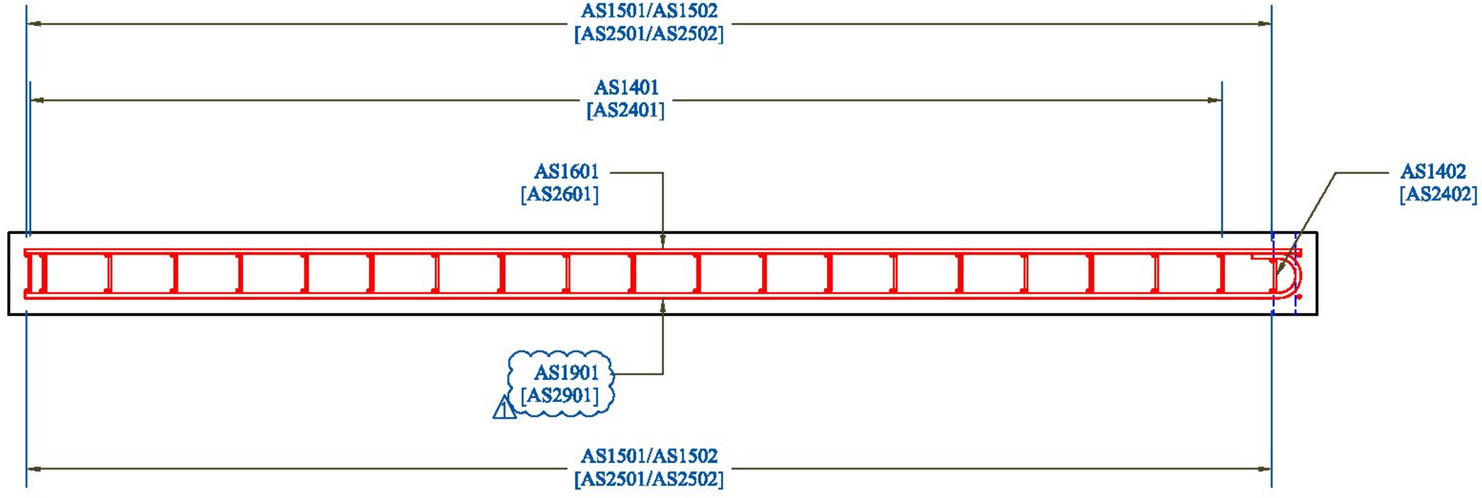

Section B-B

Vermont Agency of Transportation
RECEIVED
CK'D BY MEM OK'D BY CWC
May 29, 2015
RESUBMIT APPROVED ✓
BY C. Carlson DATE 05-29-2015

CONTRACTORS VTSPE:	Rev.	Date	By	Description
	1	04/08/15	IBA	Changes per State Review
	2	04/16/15	IBA	Changes per State Changes Received 04/13/15

PRECAST CONCRETE APPROACH SLAB SHOP DRAWINGS (SDI JOB #15738)

SUPERVISOR: E. Barendse
DETAILER: I. ADAMS
CHECKER: E. Barendse
ENGINEER: X

PROJECT NAME: Bristol BRF 021-1(29)
PROJECT #: 021-1(29)
LOCATION: Bristol, VT

INSTALLER:
S.D. Ireland
193 Industrial Ave
Williston, VT 05495

FABRICATOR:
193 INDUSTRIAL AVE.
WILLISTON, VT 05495
Ph: (802) 658-0201

SD Ireland PRECAST

03/17/2015 | SECTION_VIEWS | 6_OF_10