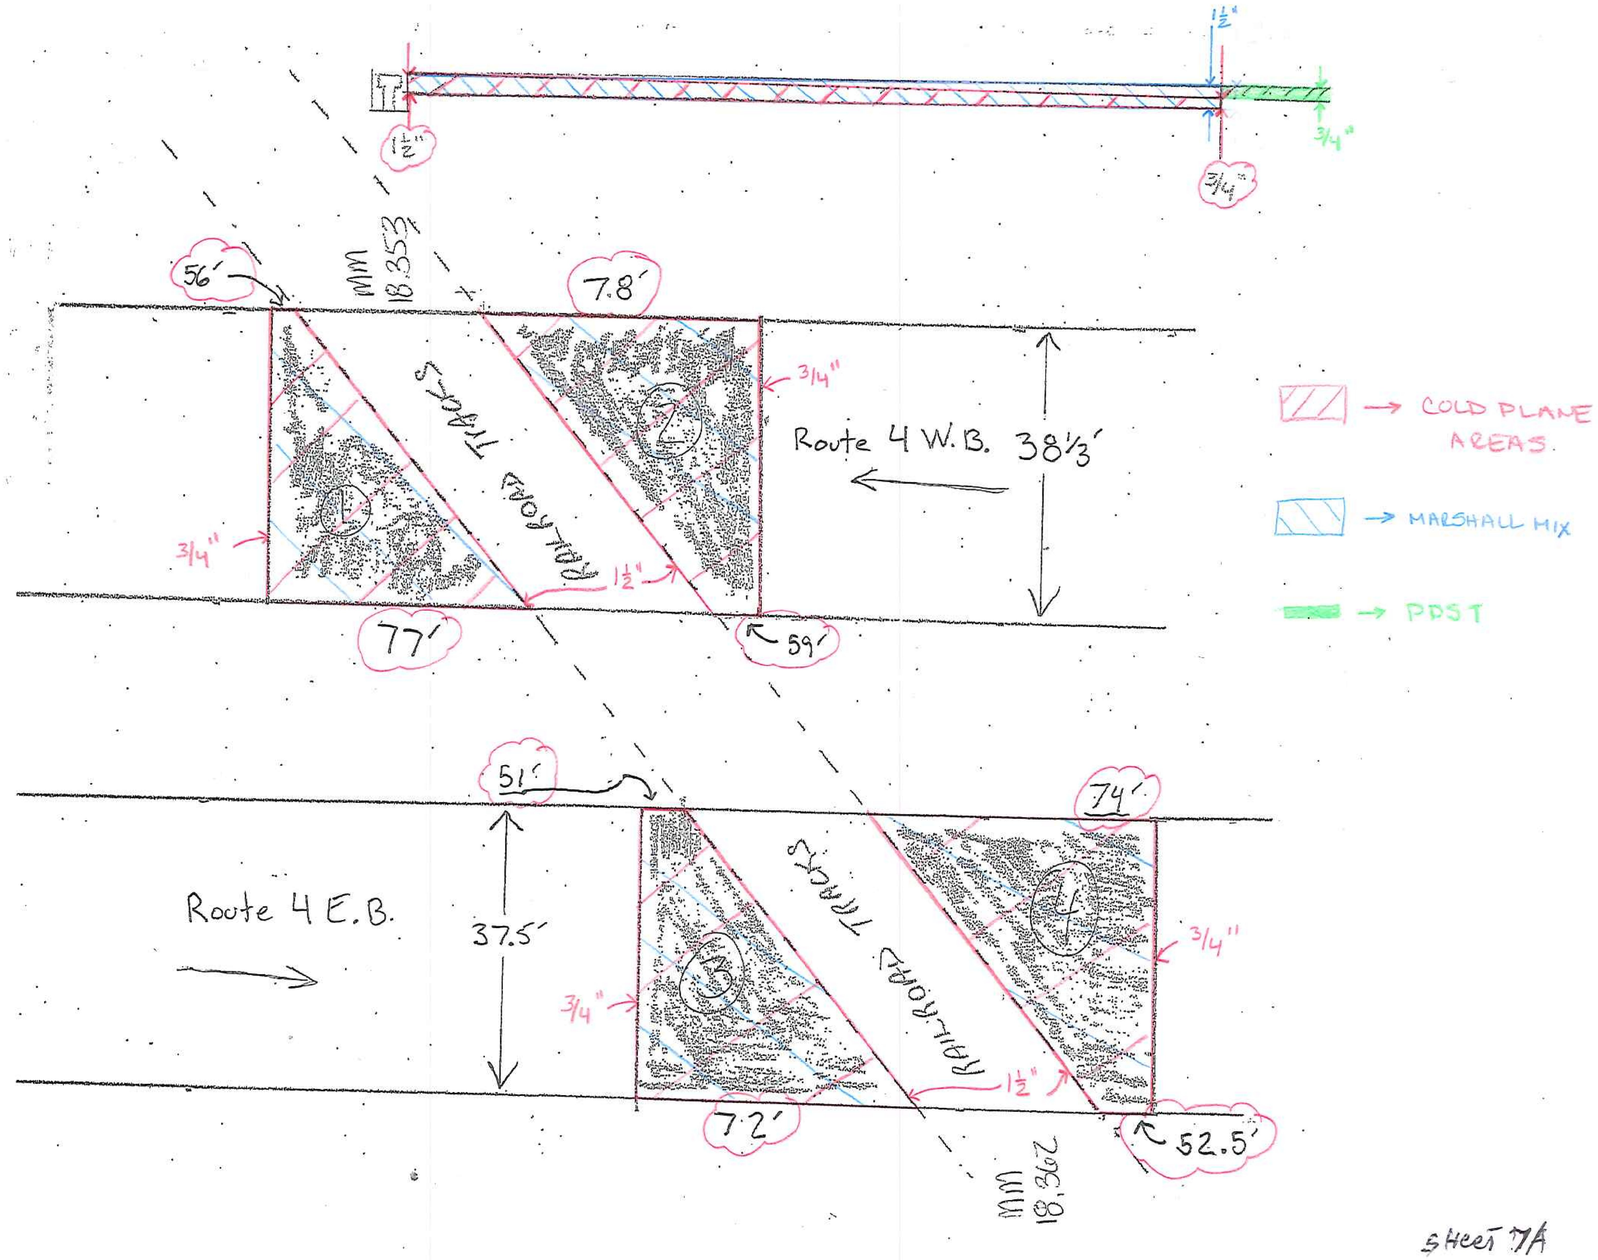

NOT TO SCALE

RAILROAD CROSSING DETAIL SHEET 7A	PROJECT NAME: FAIR HAVEN-RUTLAND TOWN PROJECT NUMBER: NH SURF(22)
FILE NAME: 10b106/10b106.dgn PROJECT LEADER: M. FOWLER DESIGNED BY: PVT. MGT. 10B106*8.i	PLOT DATE: 31-MAY-2013 11:55 DRAWN BY: S. SCHMITT CHECKED BY: PVT. MGT. SHEET 7A OF 24