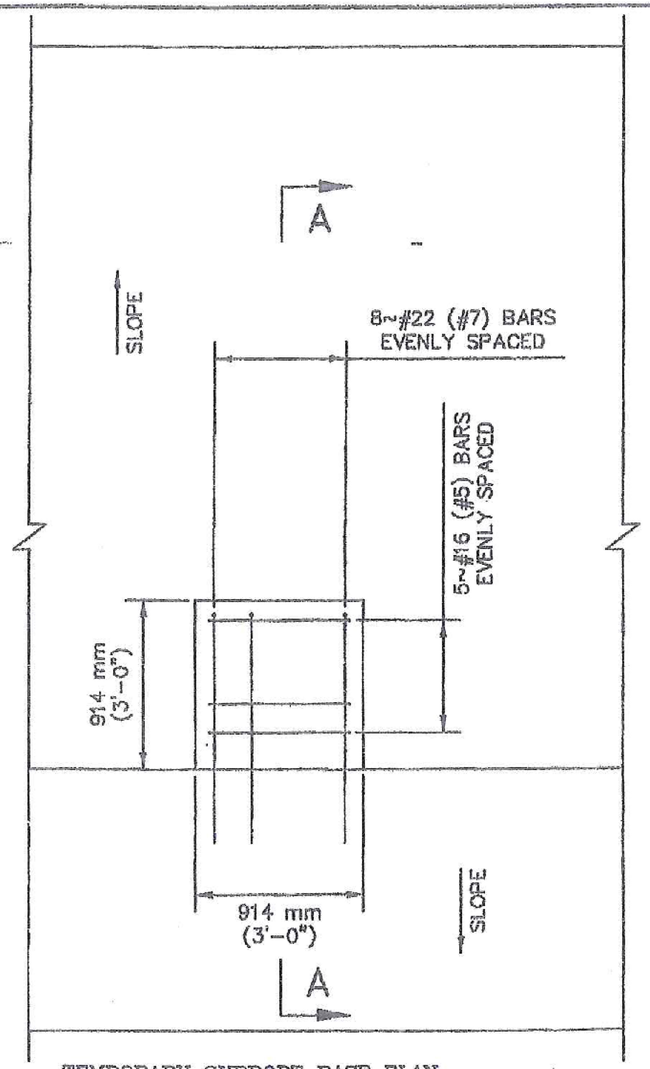

TEMPORARY SUPPORT BASE PLAN
SCALE: 1:600

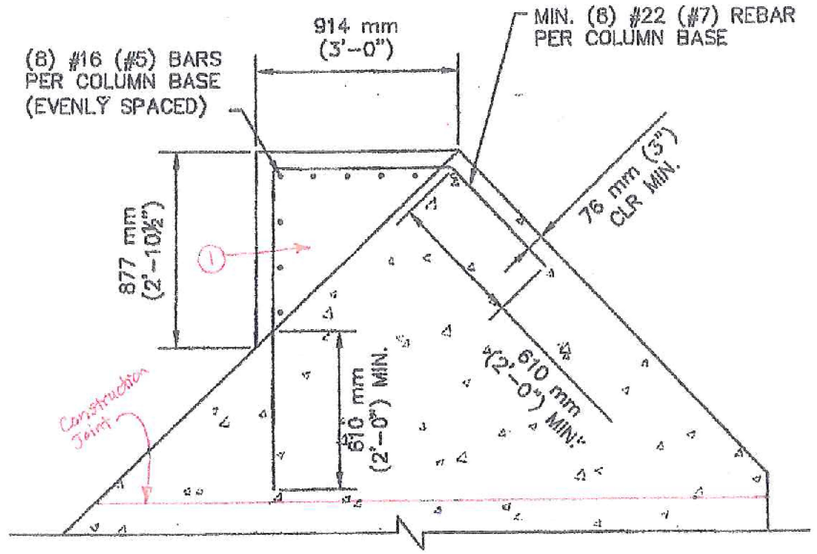

SECTION A-A
SCALE: 1:500

1 Pour pedestal integrally with upper portion of foundation.

☒ Reviewed
☐ Rejected

☐ Furnish as Corrected
☐ Revise and Resubmit
☐ Submit Specified Item

This review is only for general conformance with the design concept and the information given in the Construction Documents. Corrections or comments made on the shop drawings during this review do not relieve the contractor from compliance with the requirements of the plans and specifications. Review of a specific item shall not include review of an assembly of which the item is a component. The Contractor is responsible for dimensions to be confirmed and correlated at the jobsite; information that pertains solely to the fabrication process or to the means, methods, techniques, sequences and procedures of construction; coordination of the Work with that of all other trades and performing all Work in a safe and satisfactory manner.

McFarland-Johnson, Inc. Morrisown 17246.00

Date 12/7/12

By RJ Joy

TEMPORARY SUPPORT COLUMN BASE

No.	Description	Appd	Date
1	Rev. For M-J Comments	DBE	11/20/12

REVISIONS/NOTES

DATE: OCTOBER 10, 2012
SIGNED: SEPTIMUS
DESIGNED BY: CDG
DRAWN BY: BHB
APPROVED BY: DBE
PROJECT NO.: 12-100
FILE NO.: 12-100_INSTAL

PROPOSED BRIDGE CONSTRUCTION
VT ROUTE 100 OVER LAMOILLE RIVER
PROJECT NUMBER: STP F 022-1(22)e/1

PREPARED FOR
Hallstrom, Inc.
55 Railroad Avenue
Hyde Park, Vermont 05655

ECKMAN Engineering, LLC
1150 Lafayette Road Suite 301, PO Box 3033
Portsmouth, New Hampshire 03802
Phone: (603) 433-1354
Fax: (603) 433-2317

ER-1